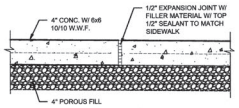

1 DETAIL — EXPANSION JOINT
SCALE: 1/4" = 1'-0"

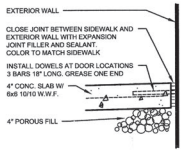

6 DETAIL — SIDEWALK AT BUILDING
SCALE: 1/4" = 1'-0"

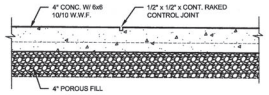

11 DETAIL — CONTROL JOINT
SCALE: 1/4" = 1'-0"

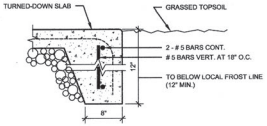

16 DETAIL — AT SIDEWALK EDGE
SCALE: 3/4" = 1'-0"

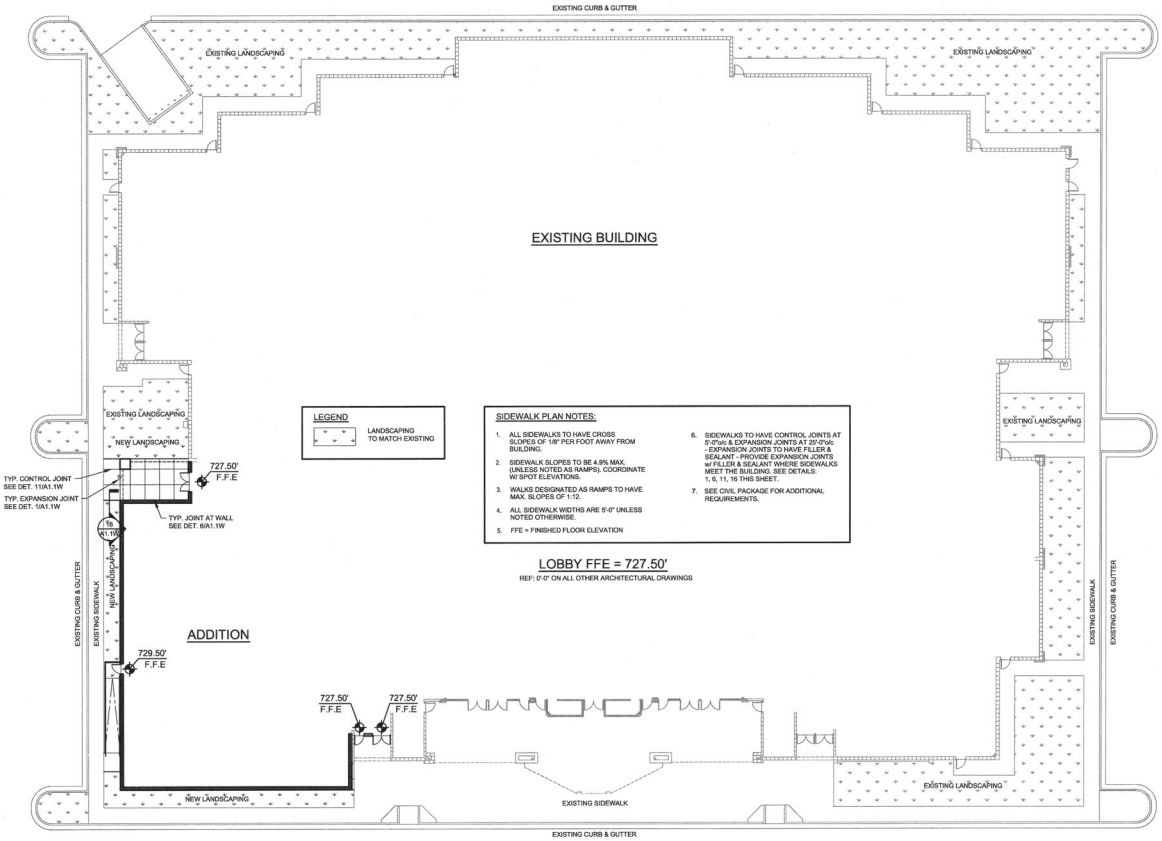

SIDEWALK PLAN
SCALE: 1/16" = 1'-0"

0 8' 16' 32'
SCALE: 1/16" = 1'-0"

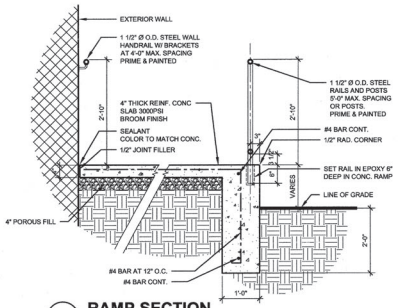

23 RAMP SECTION
SCALE: 3/4" = 1'-0"

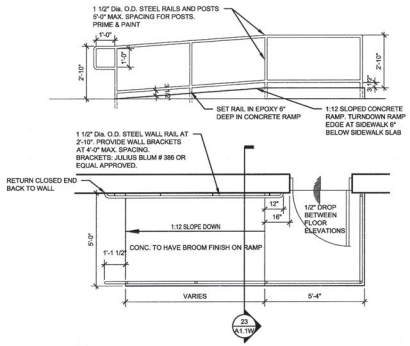

24 RAMP DETAIL
SCALE: 3/8" = 1'-0"

ARTECH ARCHITECTURE & INTERIORS
ARTECH DESIGN GROUP, INC.
CHUT TUNKASIRI
CHATTANOOGA, TN 37408
423.265.4313

CARMIKE CINEMAS, INC.
BIG-D ADDITION
2111 EAST UNIVERSITY DRIVE
AUBURN, AL

AS-BUILT

1-21-14

ISSUE DATES
INITIAL 01-21-14
1.
2.
3.
4.
5.
6.

JOB NO.	DWN	CKD
13-044	DDR	MRG

A1.1W
SIDEWALK PLAN AND DETAILS