AHWATUKEE
FOOTHILLS
HEALTH CENTER

4545 E CHANDLER BOULEVARD, PHOENIX, AZ 85050

Floor 03

Suite 300/304

AS-BUILT

8,422 SF

AVAILABLE

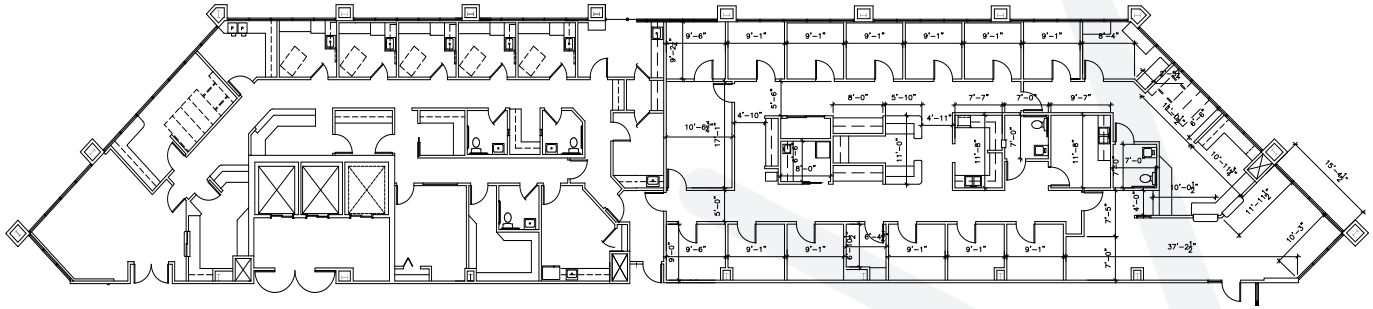

RACHAEL THOMPSON
Senior Vice President
602.513.5122
rachael.thompson@kidder.com

PERRY GABUZZI, CCIM
Executive Vice President
602.513.5116
perry.gabuzzi@kidder.com

Kidder Mathews