TAGS & LABELS

DOORS

ELECTRICAL

FIRE PROTECTION

GAS

HVAC

LIGHTING

PLUMBING

OTHER

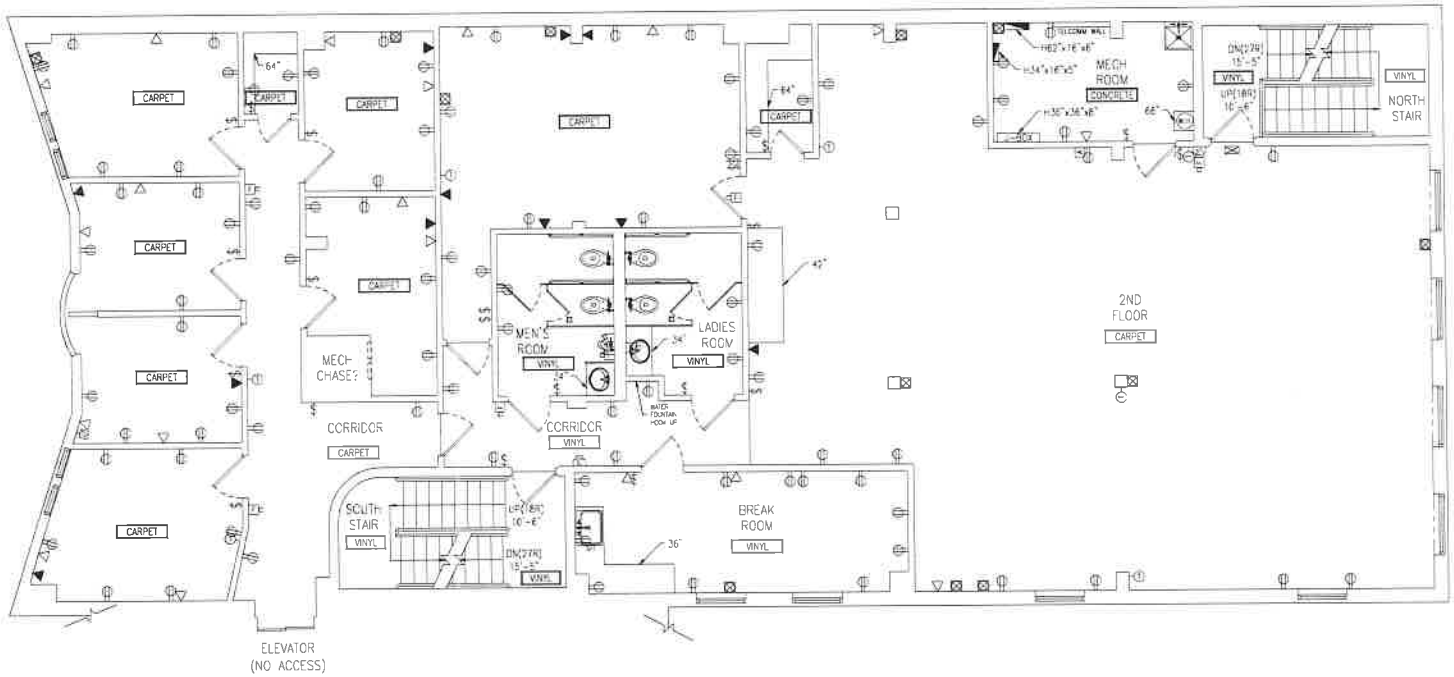

SECOND LEVEL FLOOR PLAN

UNIT: 201, Sq. ft. : 3,531

SCALE: 1/4" = 1'-0"

HAMILTON

HAMILTON DEVELOPMENT
3250 DICKERSON PIKE, SUITE 114
NASHVILLE, TN 37207

Drawn By: L. HANSON
Checked By: J. CRAWFORD
Project Number: 224165

ANNEX BUILDING
111 E 7TH STREET
CHATTANOOGA, TN 37402

COAST 2 COAST
7704 BASSWOOD DR
CHATTANOOGA TN 37416
PH 423 296 9000
www.coast2coast.net

Date: 02/16/2022

A202