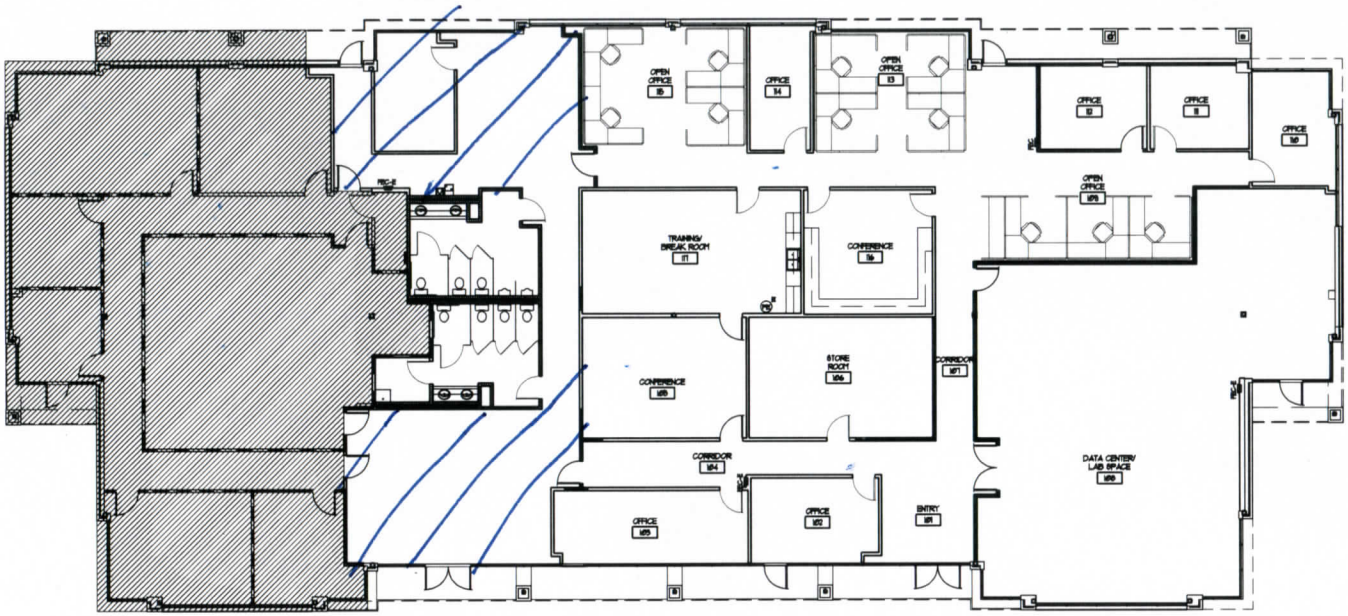

ZHONE TECHNOLOGY
SCALE: 1/16" = 1'-0"
2014-08-13