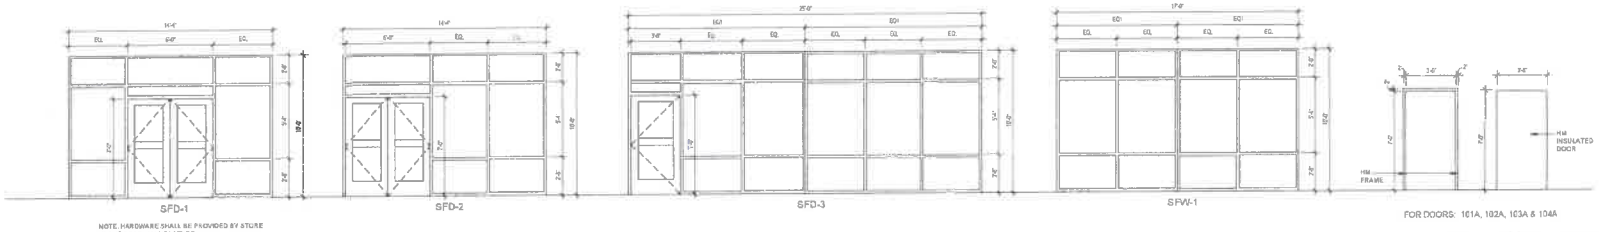

NOTE: HARDWARE SHALL BE PROVIDED BY STORE FRONT DOOR MANUFACTURE.

STOREFRONT DOOR & WINDOWS

SCALE: 1/4" = 1'-0"

FOR DOORS: 101A, 102A, 103A & 104A

HOLLOW METAL DOOR & FRAME

SCALE: 1/4" = 1'-0"

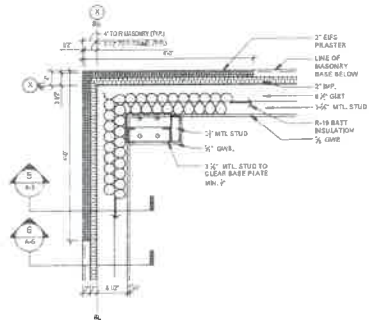

2 TYPICAL CORNER PILASTER DETAIL

SCALE: 3/4" = 1'-0"

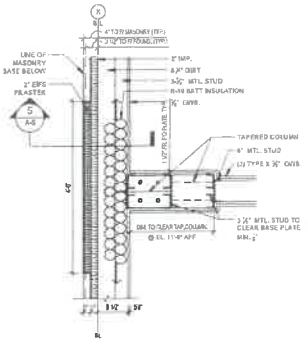

3 TYPICAL PILASTER DETAIL

SCALE: 3/4" = 1'-0"

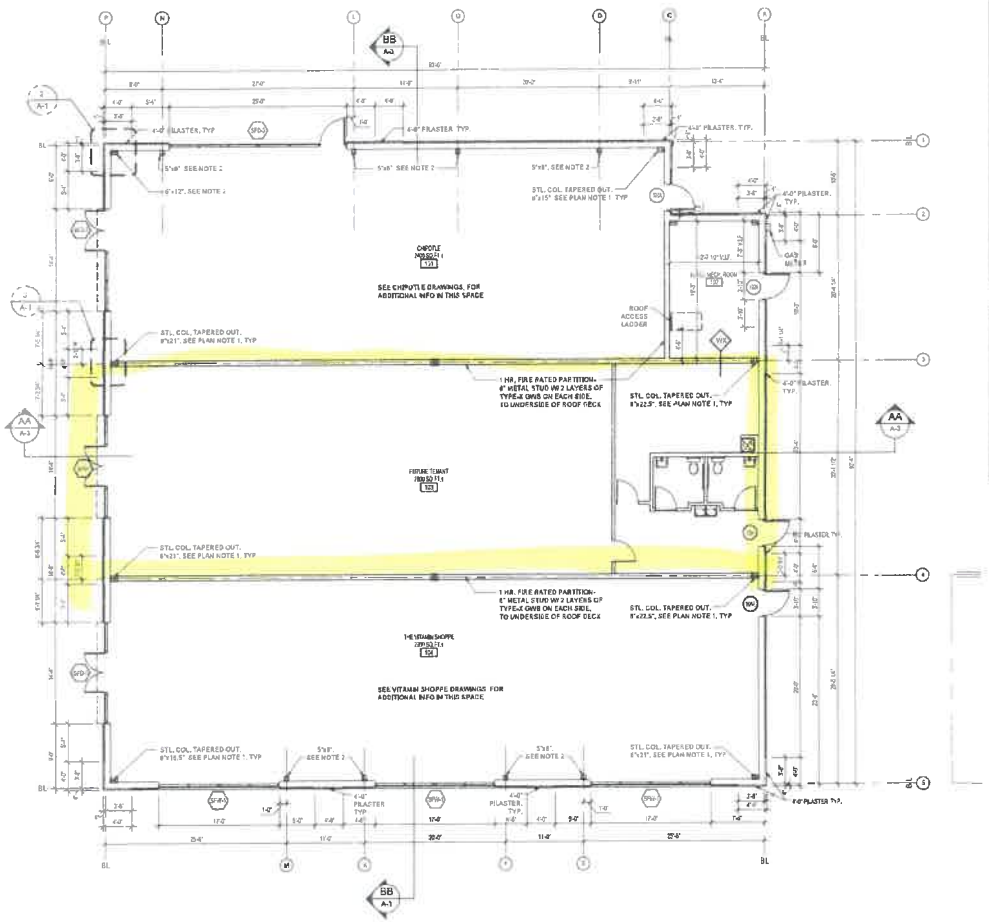

FLOOR PLAN

SCALE: 1/8" = 1'-0"

HARDWARE SETS

HARDWARE SET #1 DOOR TYPE SFD-1 SFD-2

		ENTRY PASSAGE		
1	EA	CONTINUOUS HINGE	224HD - CLEAR ANODIZED ALUMINUM	STANLEY
1	EA	EXIT DEVICE	CD98 F 628	VON DUPRIN
1	EA	EXIT DEVICE	98D CD F628	VON DUPRIN
1	EA	CYLINDER	HOUSE	BEST
2	EA	CYLINDER	1E4	BEST
2	EA	OFFSET PULL	BF457 F689	ROCKWOOD
2	EA	CLOSER	3001 689	STANLEY CM
1	SET	SEALS	INTERNAL TO DOOR FRAME	
2	EA	SWEEP	CS274 X DOOR WIDTH	NOT
1	EA	THRESHOLD	896 X REVERSED WIDTH	NOT

HARDWARE SET #2 DOOR TYPE SFD-3

		ENTRY PASSAGE	
1	EA	CONTINUOUS HINGE	CFM77 X 83 X 525 X 628
1	EA	EXIT DEVICE	98D CD F628
1	EA	CYLINDER	MORTISE 626
1	EA	CYLINDER	1E4 626
1	EA	OFFSET PULL	BF457 F689
1	EA	CLOSER	3001 689 SHW
1	SET	SEALS	INTERNAL TO DOOR FRAME
1	EA	SWEEP	CS274 X DOOR WIDTH
1	EA	THRESHOLD	896 X REVERSED WIDTH

PLAN NOTES

1. STEEL COLUMN TAPERED OUT. DIMENSIONS ARE COLUMN WIDTH AND DEPTH AT BLDG. 11'-8" A.F.F., SEE PLAN DETAIL 3/A-1 FOR TYPICAL COLUMN ENCLOSURE
2. DIMENSIONS ARE COLUMN WIDTH AND DEPTH. SEE PLAN 3/A-1 FOR TYPICAL COLUMN ENCLOSURE.

GENERAL NOTE FOR 1 & 2:
CONTRACTOR TO VERIFY ALL COLUMNS CONDITION IN THE FIELD.
FOR ADDITIONAL INFORMATION, SEE VARIOUS PLAN DRAWINGS.

REVISIONS

NO.	DESCRIPTION	DATE	BY

PROPOSED RETAIL/ RESTAURANT BUILDING

245 WHITING FARMS ROAD, HOLYOKE, MA 01040

AS BUILT

SHEET TITLE: FLOOR PLAN

SHEET NUMBER: A-1