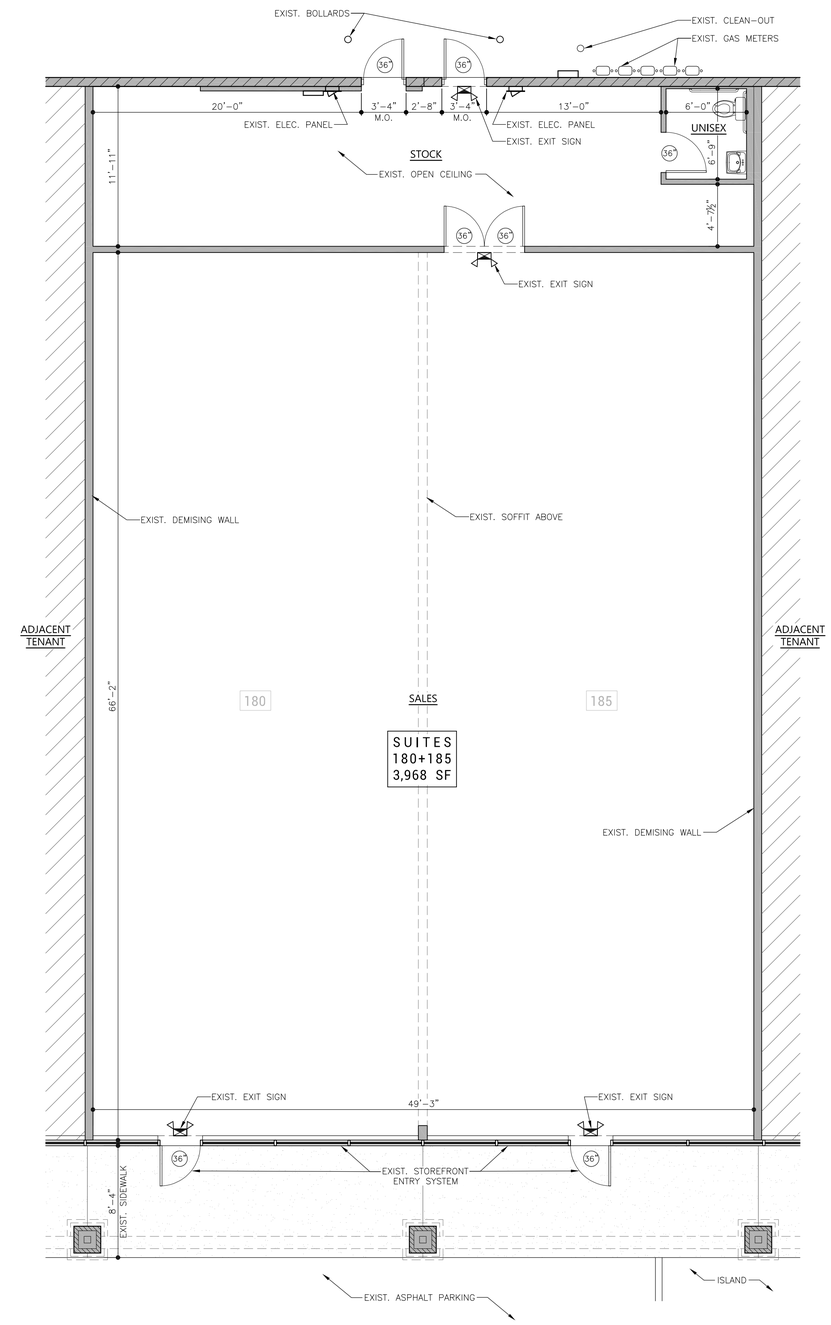

A

AS-BUILT FLOOR PLAN - SUITES 180 + 185

SCALE: 3/16"=1'-0"

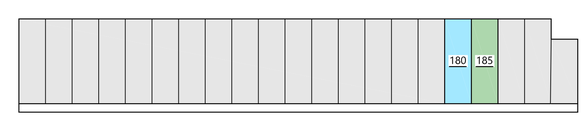

KEY MAP

N.T.S.

DRAWN BY:
CAD Group
208 Percheron Drive
Richmond, KY 40475
Office: 859.575.2488
info@cadgroup.biz

OWNER:
Equity Management Group, Inc.
840 EAST HIGH STREET . LEXINGTON, KY 40502 . 859.266.1414

PROJECT:
TIVERTON CROSSING
130 W. TIVERTON WAY
SUITES 180 + 185
LEXINGTON, KY 40502

AS-BUILT FLOOR PLAN

THESE ARE AS-BUILT DRAWINGS; DRAWN AT THE REQUEST OF THE PROPERTY OWNER OR REPRESENTATIVE. THE INFORMATION ON THESE PLANS WAS TAKEN FROM MEASUREMENTS, PHOTOS, ETC. THE BEST OF MY KNOWLEDGE THESE PLANS ARE DRAWN TO COMPLY WITH OWNER'S REQUEST AND ARE DRAWN VERY ACCURATELY. HOWEVER, THE DESIGNER CANNOT GUARANTEE THE ACCURACY OF THE INFORMATION VERIFIABLE. SO AT TIMES CERTAIN ASSUMPTIONS ARE MADE. THE PROPERTY OWNER OR REPRESENTATIVE ACCEPTS THE RESPONSIBILITY FOR THE ACCURACY AND INFORMATION ON THE ENCLOSED DRAWING(S). CAD GROUP IS NOT LIABLE FOR DEFECTIVE DATA RECEIVED FROM THE PROPERTY OWNER OR REPRESENTATIVE. THE PREPARATION OF THESE PLANS TO AVOID MISTAKES, THE DESIGNER CANNOT GUARANTEE ALL ERRORS OR OMISSIONS WILL BE AVOIDED. THE PROPERTY OWNER OF ANY TEAM IS NEEDED ON THE DRAWINGS, PLEASE NOTIFY CAD GROUP.

REVISIONS/RELEASES:

INFO:	
DRAWN BY:	CES
CHKD. BY:	–
DATE:	11 AUG 2023
SCALE:	AS NOTED

SHEET **AB1.1**

CG PROJECT: 23609