Alt Springs As Built Marketing Package

442 Northlake Blvd, Alt Springs, FL 32701, US

Building: 442
Suite: 1000-1008
Sheet E1

Scale: Not to Scale
Sheet Size: 42" x 30"
Not For Construction

BAY SPACE

Property Key

Usable Square Foot Analysis

Office Area	12,924	100 %
Warehouse Area	0	0%
Total Area	12,924	

Building Information

Deck Height:	14' - 3 1/2"
Clear Height:	9' - 0"
Ceiling Height:	7' - 5 1/2"
Sprinklered:	■ Yes ☐ No
Mechanical Area:	0 SQFT

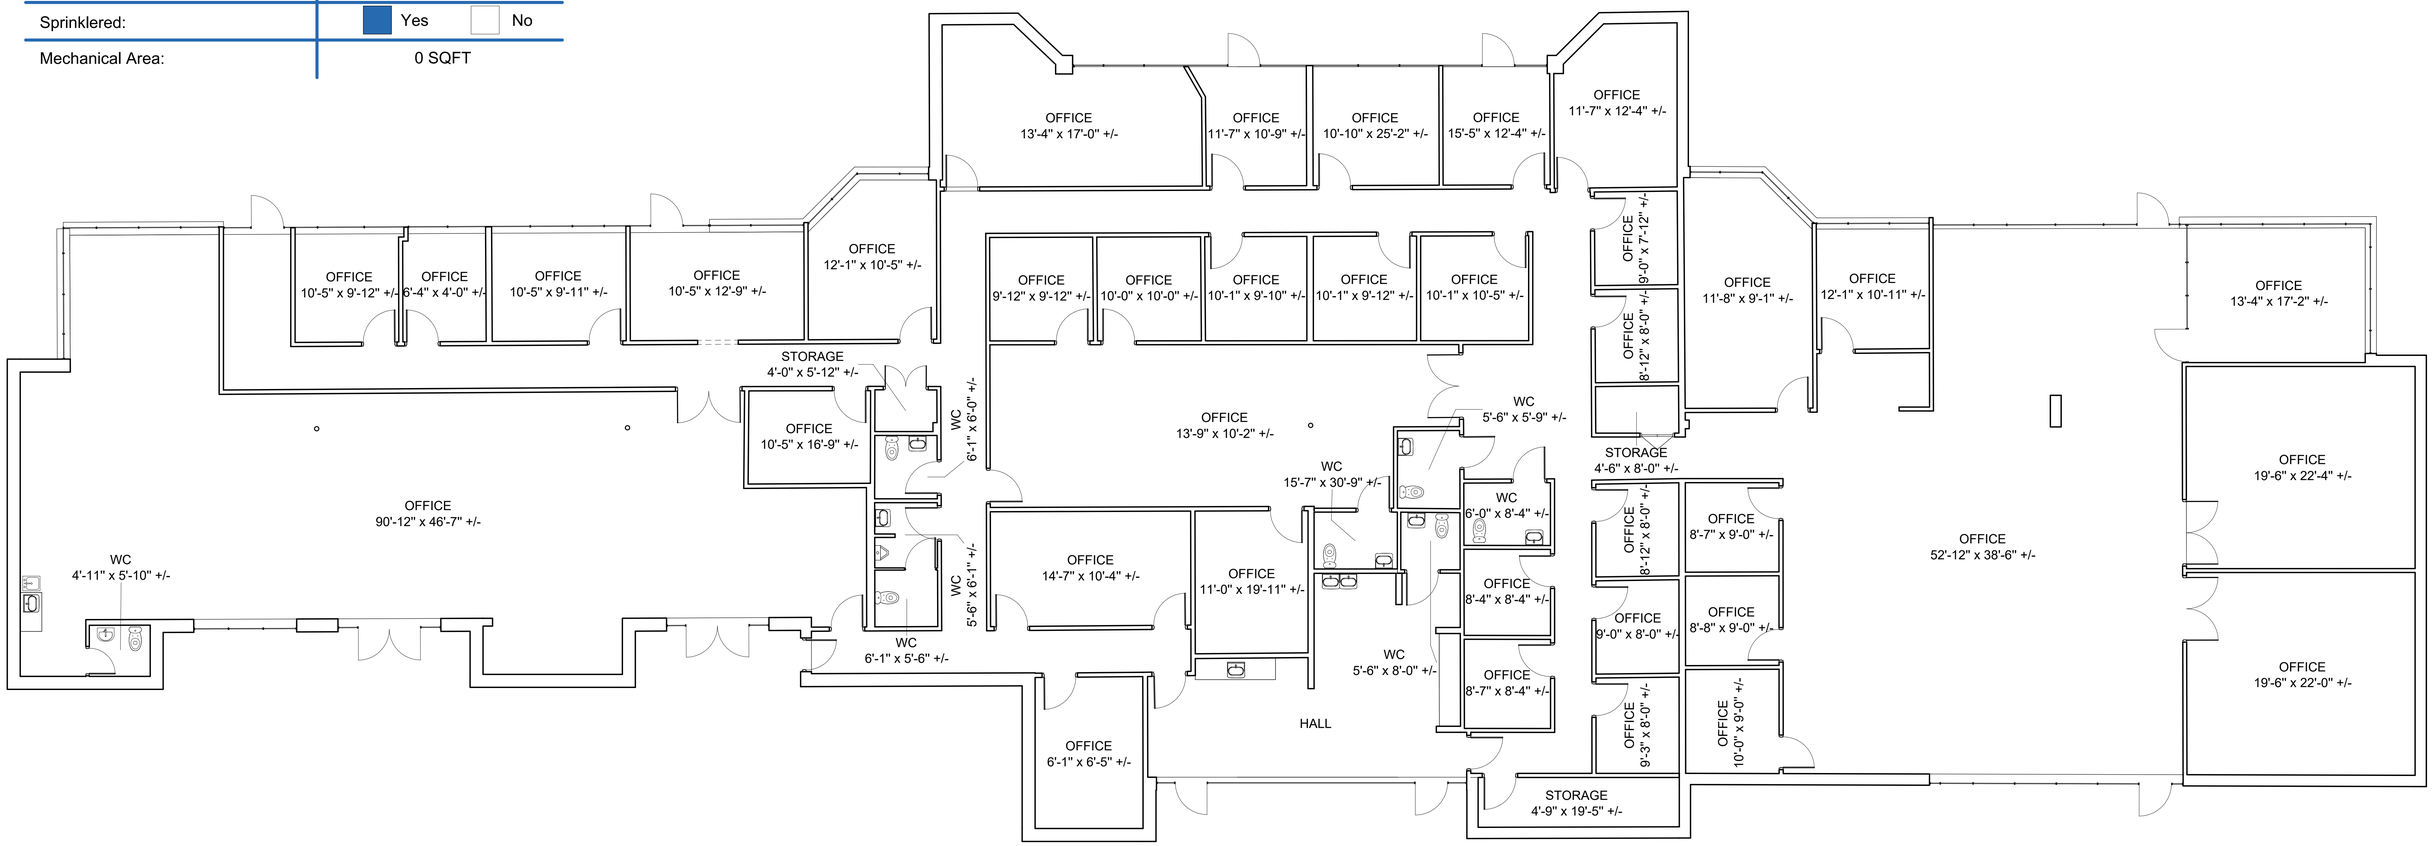

As Built Floor Plan for Marketing