12,170

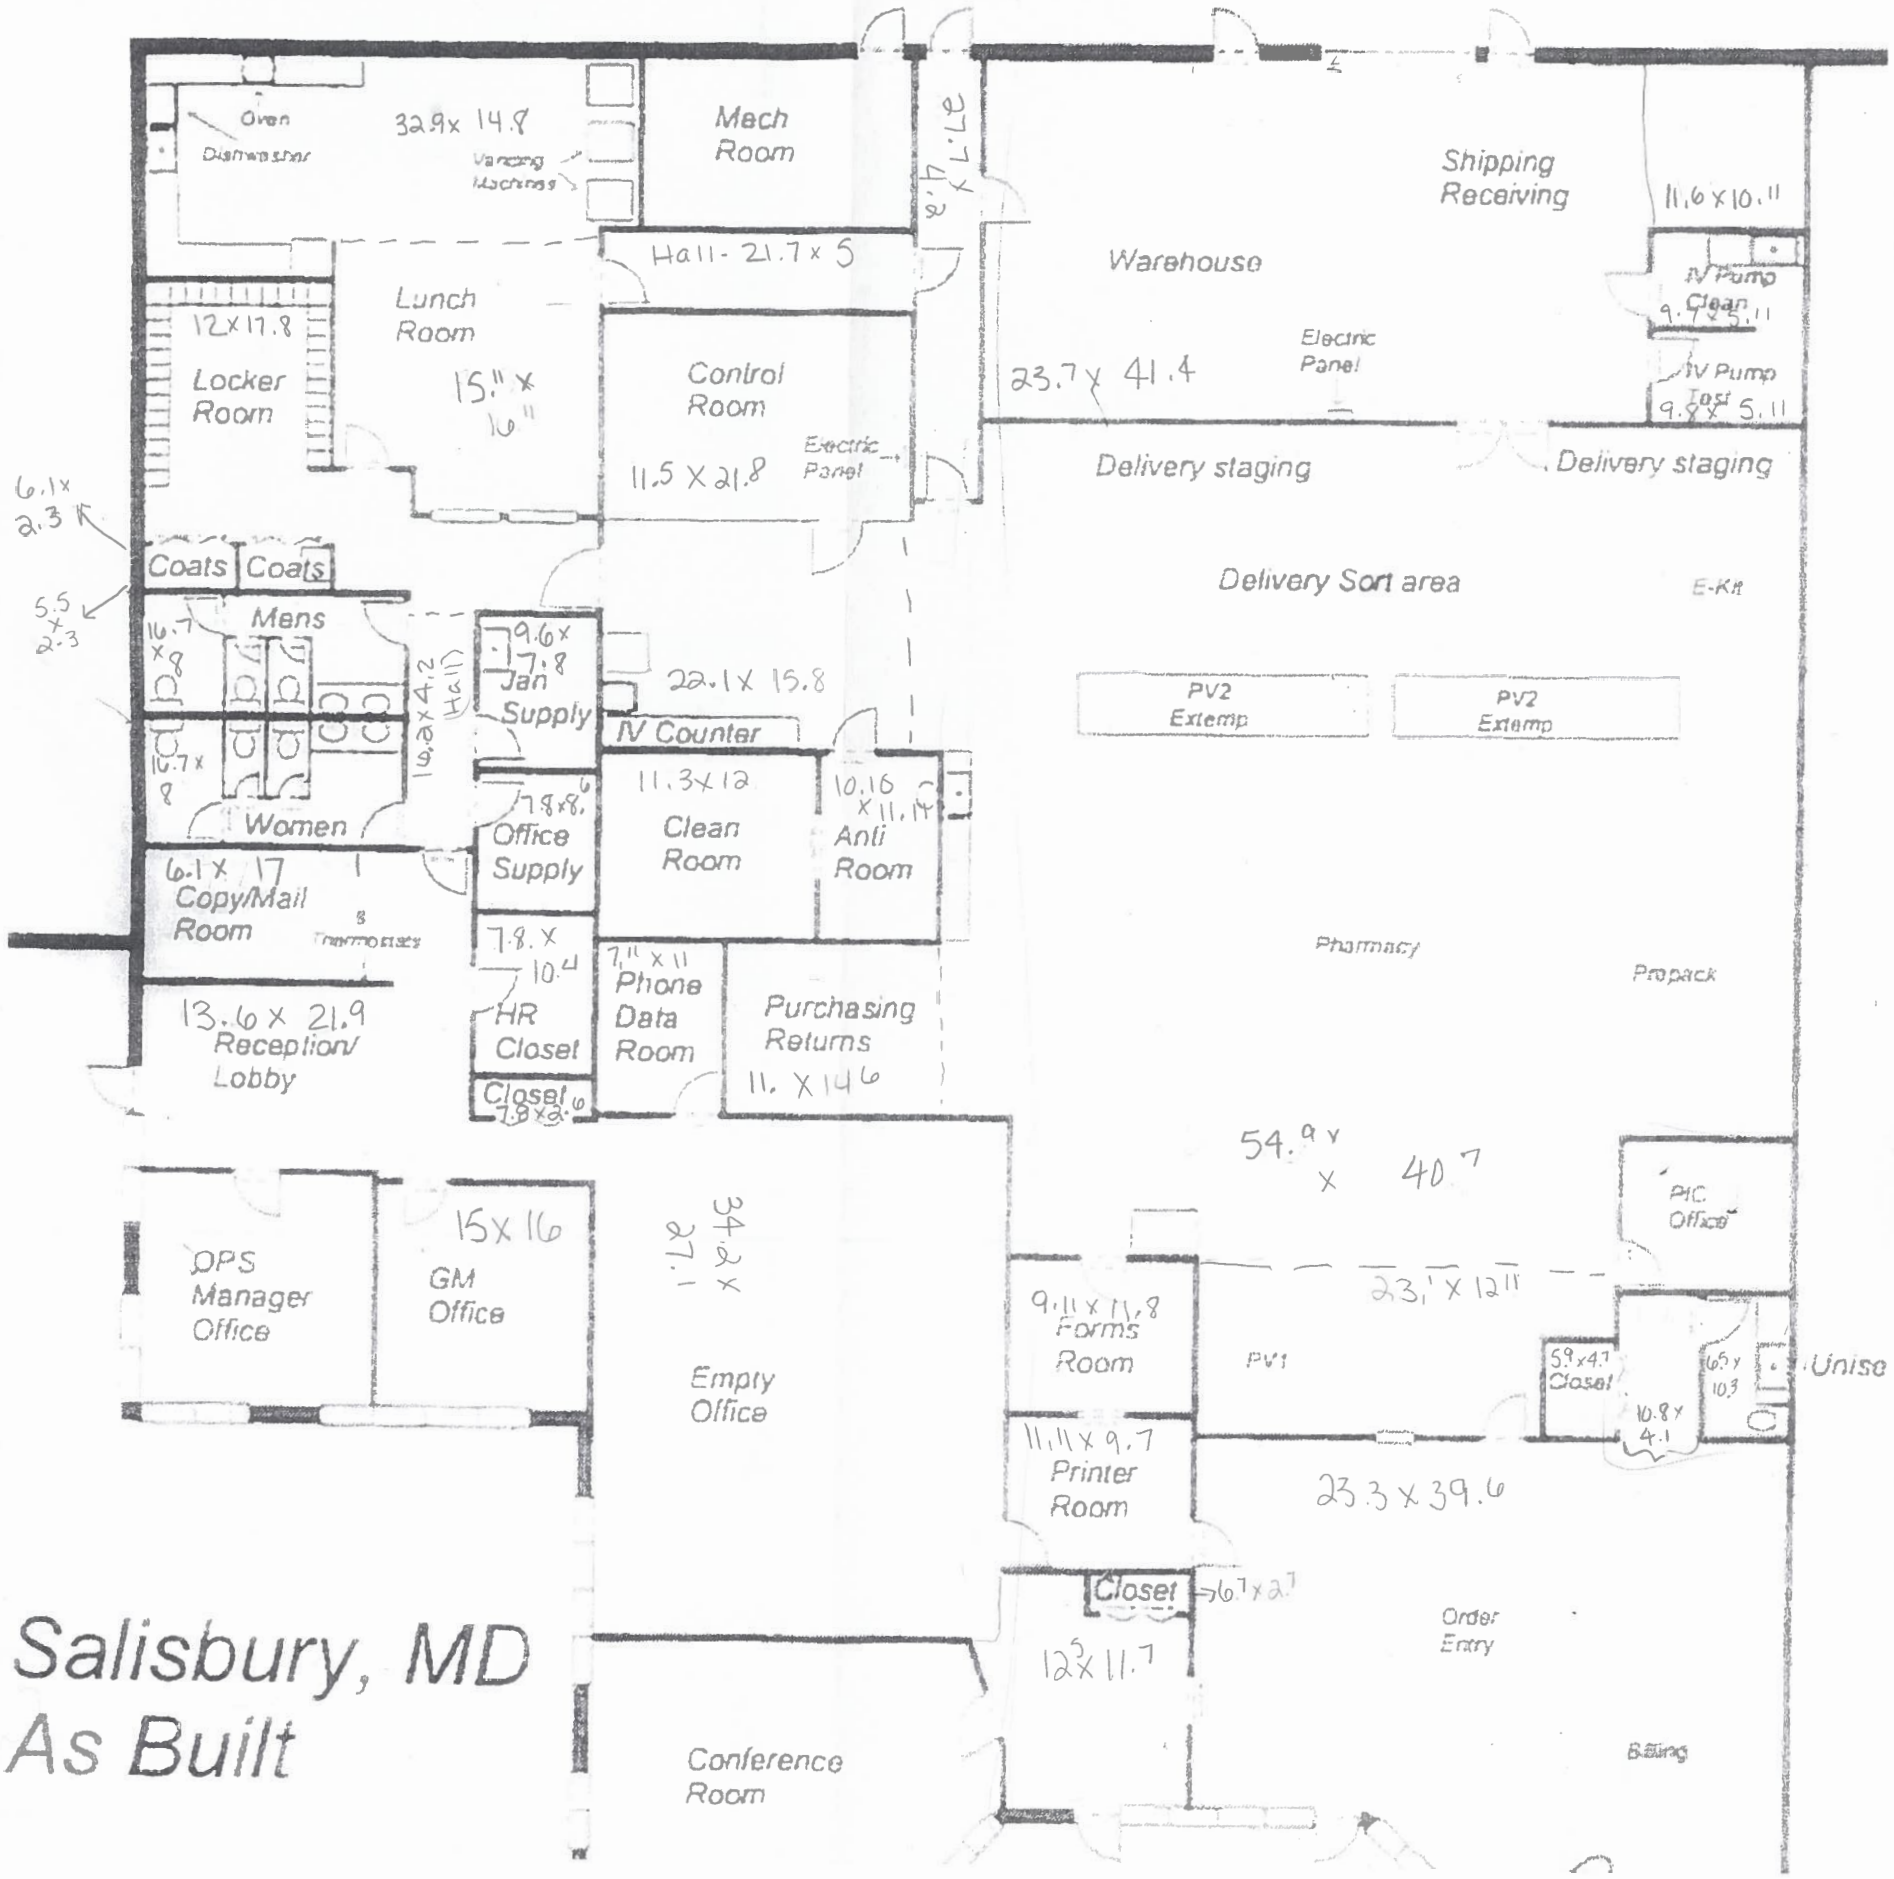

Salisbury, MD
As Built