DIVERSIFIED ENVIRONMENTAL MANAGEMENT COMPANY
MINNEOLA, FL

LEGEND:

R	RADIUS
Δ	CENTRAL ANGLE
L	LENGTH
CH	CHORD
CB	CHORD BEARING
T.B.	TANGENT BEARING
(M)	MEASURED
(R)	PLAT
(C)	CALCULATED
(D)	DESCRIPTION
POB	POINT OF BEGINNING
POC	POINT OF COMMENCEMENT
O.R.	OFFICIAL RECORDS BOOK
PG.	PAGE
TYP.	TYPICAL
P.T.	POINT OF TANGENCY
P.C.	POINT OF CURVATURE
	IRON ROD & CAP
	NAIL & DISC
	4"x4" CONCRETE MONUMENT
	IRON PIPE
	BARBED WIRE FENCE
	WOOD FENCE
	CHAIN LINK FENCE
	EDGE OF ASPHALT PAVEMENT
	CENTERLINE
	SINGLE POST SIGN
	DOUBLE POST SIGN
	WELL
	ELECTRICAL OUTLET
	TELEPHONE RISER
	FIRE HYDRANT
WM	MASTER WATER ASSEMBLY
	SEWER VALVE
	WATER VALVE
RWV	RECLAIMED WATER VALVE
	IRRIGATION VALVE
	GAS VALVE
	SANITARY MANHOLE
	DRAINAGE MANHOLE
	TELEPHONE MANHOLE
	GREASE TRAP MANHOLE
	POWER MANHOLE
	WATER SHUT-OFF VALVE
	POWER TRANSFORMER
	WATER METER
	GAS METER
	POWER METER
	ELECTRC HAND HOLE
	CABLE TELEVISION RISER
	TELEPHONE ACCESS CABINET
LB	LICENSED BUSINESS
PSM	PROFESSIONAL SURVEYOR & MAPPER
PLS	PROFESSIONAL LAND SURVEYOR
PVC	POLYVINYL CHLORIDE PIPE
RCP	REINFORCED CONCRETE PIPE
CMP	CORRUGATED METAL PIPE
DIP	DUCTILE IRON PIPE
VCP	VITRIFIED CLAY PIPE
CPP	CORRUGATED PLASTIC PIPE
—OHW—	OVERHEAD UTILITY WIRES
—UGP—	UNDERGROUND POWER LINE
—UGG—	UNDERGROUND GAS LINE
—UGT—	UNDERGROUND TELEPHONE LINE
—UGCT—	UNDERGROUND CABLE TELEVISION
—FOC—	FIBER OPTIC CABLE
	WOODEN UTILITY POLE
	CONCRETE UTILITY POLE
	GUY POLE
	GUY ANCHOR
INV=69.73	INVERT ELEVATION
+ 68.51	EXISTING GROUND ELEVATION
60	EXISTING GROUND CONTOUR
	HANDICAPPED PARKING SPACE (H/C)
	SITE BENCH MARK (AS INDICATED)
	WATER BLOW-OFF VALVE
	CLEAN-OUT
	FIRE DEPARTMENT CONTROL VALVE
	CATCH BASIN
	DRAIN
	CURB INLET
C.I.	CURB INLET WITHOUT MANHOLE
	MITERED END SECTION
VAULT	UTILITY VAULT
A/C	AIR CONDITIONER
PB	POWER BOX
MW	MONITORING WELL
	LIGHT POLE
	BOLLARD
	CONCRETE RUBBLE ENERGY DISSIPATER
	GRAVEL ENERGY DISSIPATER

DESCRIPTION:

THE NORTHWEST 1/4 OF THE NORTHEAST 1/4 OF THE SOUTHWEST 1/4 OF SECTION 7, TOWNSHIP 22 SOUTH, RANGE 26 EAST, LAKE COUNTY, FLORIDA, LESS THE RIGHT OF WAY FOR STATE ROAD 25 AND LESS THE NORTH 25 FEET FOR ROAD RIGHT OF WAY.

AND

THE NORTHEAST 1/4 OF THE NORTHEAST 1/4 OF THE SOUTHWEST 1/4 OF SECTION 7, TOWNSHIP 22 SOUTH, RANGE 26 EAST, LAKE COUNTY, FLORIDA.

GRAPHIC SCALE

50 0 25 50 100 200

(IN FEET)
1 inch = 50 ft.

SURVEYORS NOTES:

1. *NOT VALID WITHOUT THE SIGNATURE AND THE ORIGINAL RAISED SEAL OF A FLORIDA LICENSED SURVEYOR AND MAPPER.*
2. *LANDS SHOWN HEREON WERE NOT ABSTRACTED FOR RIGHTS OF WAY, EASEMENTS, OWNERSHIP, OR OTHER INSTRUMENTS OF RECORD, BY THIS FIRM.*
3. *REVISIONS DO NOT CONSTITUTE A RECERTIFICATION OF THE EXISTING FIELD CONDITIONS OF THIS SURVEY.*
4. *BEARINGS, COORDINATES AND ELEVATIONS SHOWN HEREON ARE BASED ON STATE PLANE COORDINATES FLORIDA ZONE EAST PER LOCAL GIS MONUMENTS.*
   - *LAKE COUNTY GIS MONUMENT DESIGNATION LK 152, N 1554684.530 E 413445.765 (NAD83), ELEV. 226.327 (NAVD 1988)*
   - *LAKE COUNTY GIS MONUMENT DESIGNATION LK 154, N 1554680.581 E 419563.484 (NAD83), ELEV. 216.097 (NAVD 1988).*
5. *THE DESCRIPTION SHOWN HEREON WAS SUPPLIED BY THE CLIENT.*
6. *THIS IS NOT A BOUNDARY SURVEY.*
7. *NO INTERIOR IMPROVEMENTS HAVE BEEN LOCATED UNLESS OTHERWISE INDICATED.*
8. *SITE BENCH MARKS ARE AS SHOWN HEREON.*
9. *THE ELECTRONIC FILE FOR THIS PROJECT IS THE PROPERTY OF BISHMAN SURVEYING AND MAPPING, INC. AND IS NOT THE PROPERTY OF THE CLIENT.*
10. *THE BOUNDARY INFORMATION SHOWN HEREON IS BASED ON A BOUNADRY SURVEY BY RHODEN LAND SURVEYING, INC., JOB NO. 01028.008 DATED 4/16/01 WITH A REVISION DATE OF 7/23/04.*

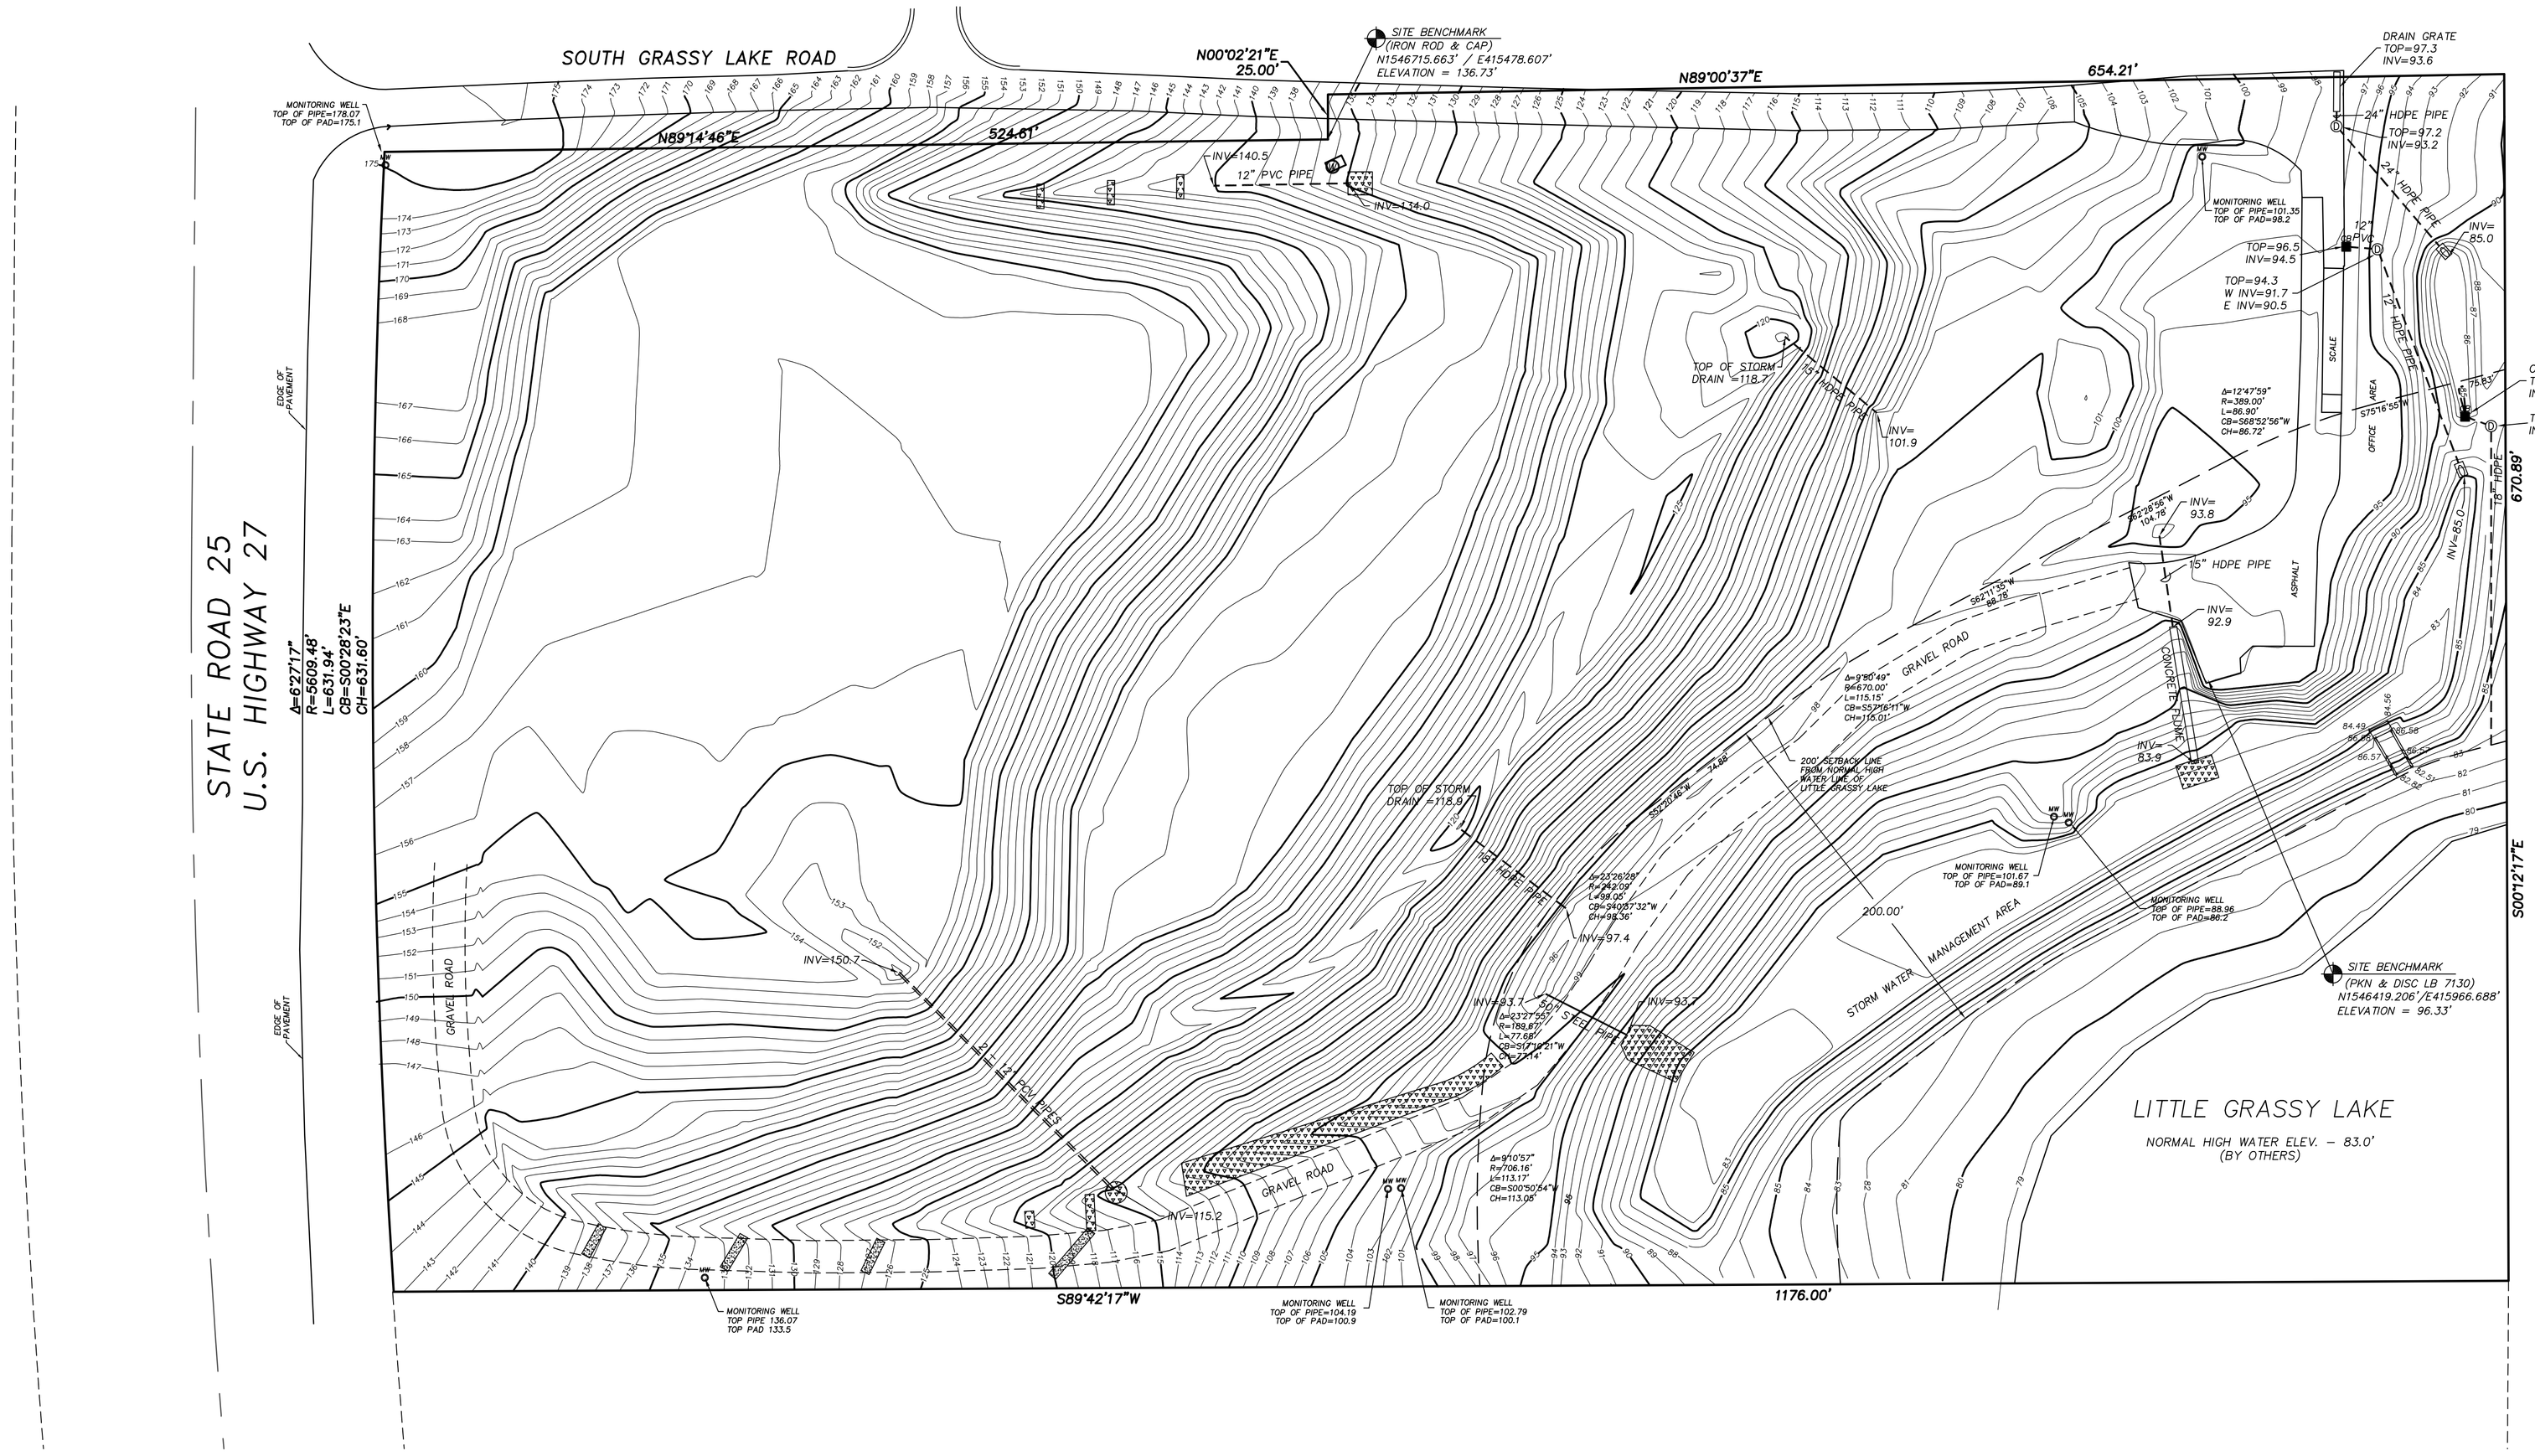

SHEET 1 OF 1

SECTION 7 TOWNSHIP 22 SOUTH RANGE 26 EAST

132 W. PLANT STREET, SUITE 210
WINTER GARDEN, FL 34787
CERTIFICATE OF AUTHORIZATION LB 7274
Phone No. 407.905.8877
Fax No. 407.905.8875
E-mail: bsmrc@earthlink.net

BISHMAN SURVEYING AND MAPPING, INC.

SPECIFIC PURPOSE SURVEY
FINAL COVER CONTOUR AS-BUILT

AARON D. BISHMAN, P.S.M. FLORIDA REGISTRATION NO. 5668

REVISIONS:

JOB NUMBER: 06168.006

SURVEY DATE:	12/24/09
FIELD BY:	A.BISHMAN
FIELD BOOK:	
PAGES:	
FIELD FILE:	
DRAWING FILE:	06168-6.DWG