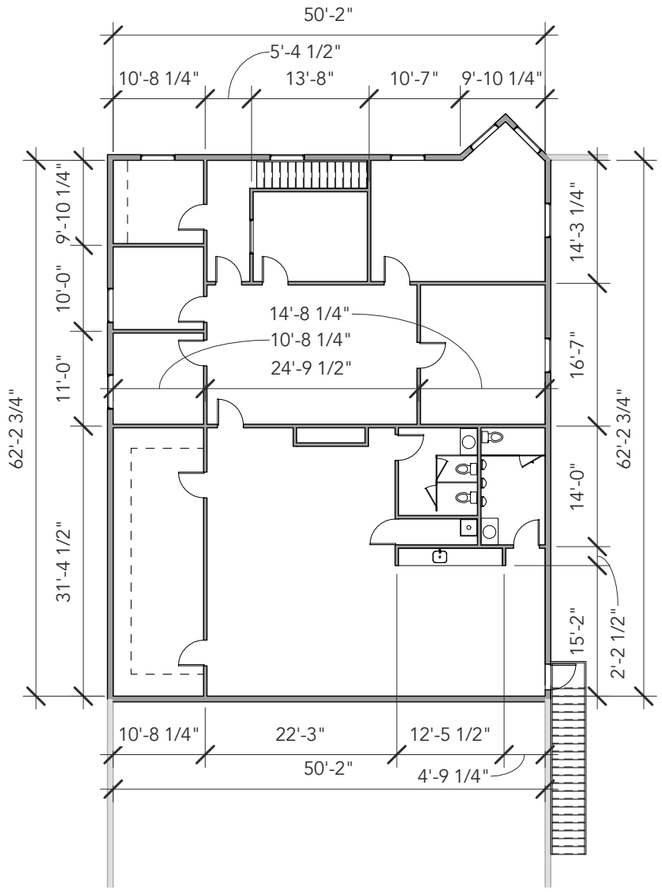

2 Level 02 Floor Plan
1/16" = 1'-0"

3,297 SqFt Total
Including Outside Walls

First Floor	13,548 SqFt
Second Floor	3,297 SqFt
Total	16,845 SqFt

The dimensions provided are rough in nature and are meant to be for general information only. Do not use for construction planning purposes or for detailed space planning purposes without confirming all dimensions in field.

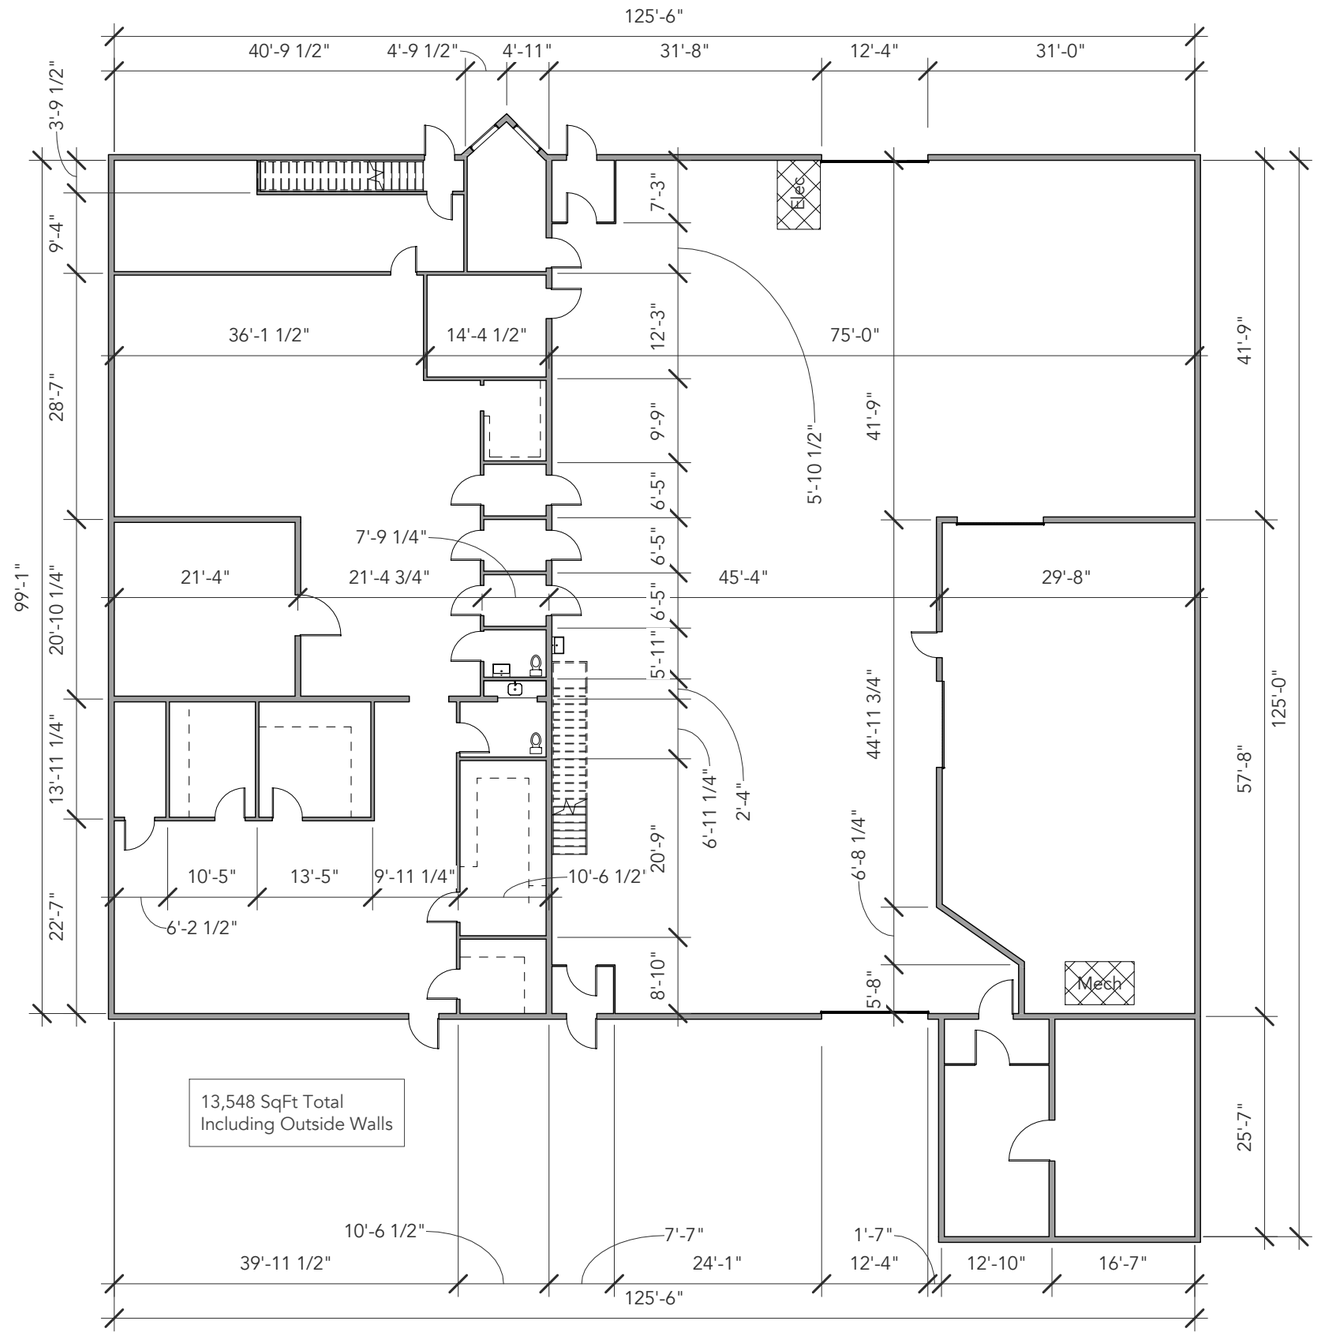

1 Level 01 Floor Plan
1/16" = 1'-0"

Floor Plans
A001

COMMON WORKS ARCHITECTS

Copyright 2019 © COMMON WORKS ARCHITECTS, PLLC

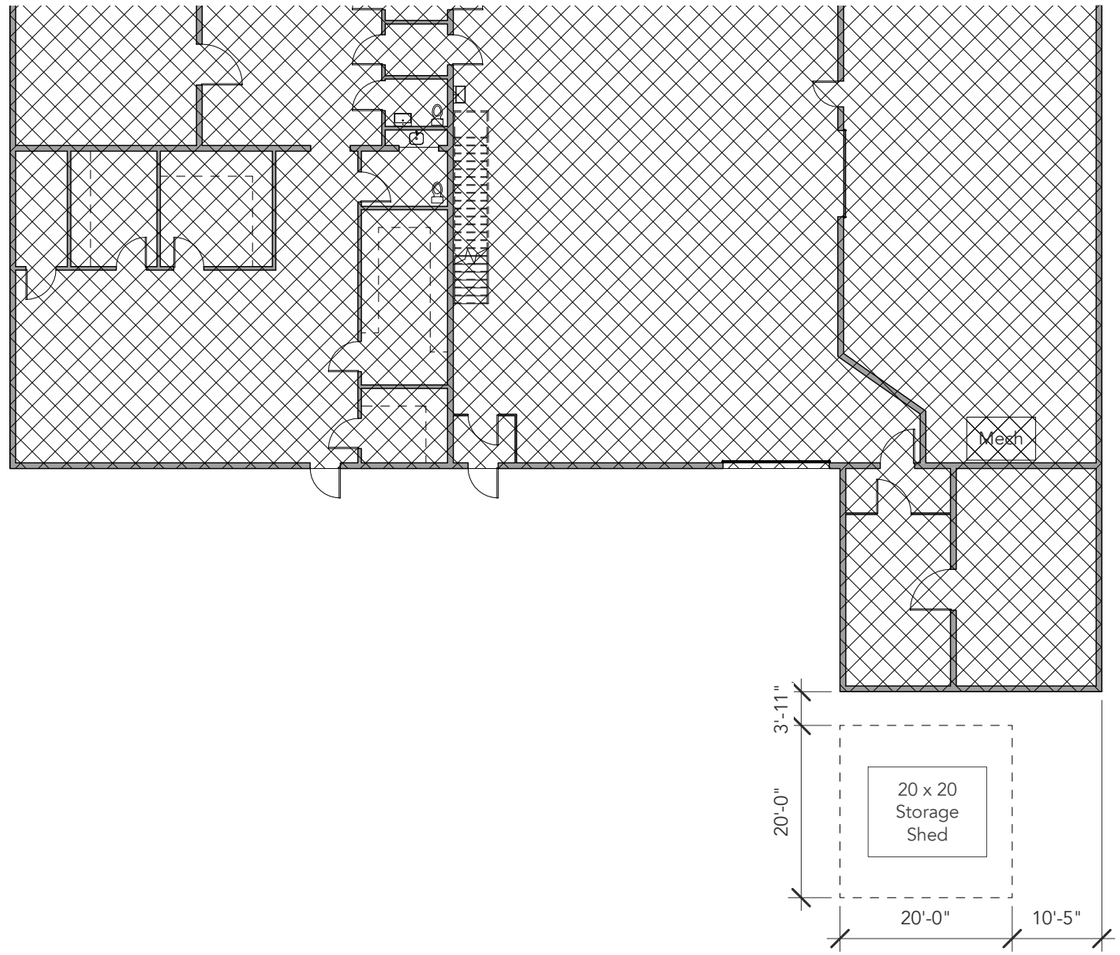

1 South storage shed plan
1/16" = 1'-0"

Shed Plan

A002

COMMON WORKS ARCHITECTS

Copyright 2019 © COMMON WORKS ARCHITECTS, PLLC