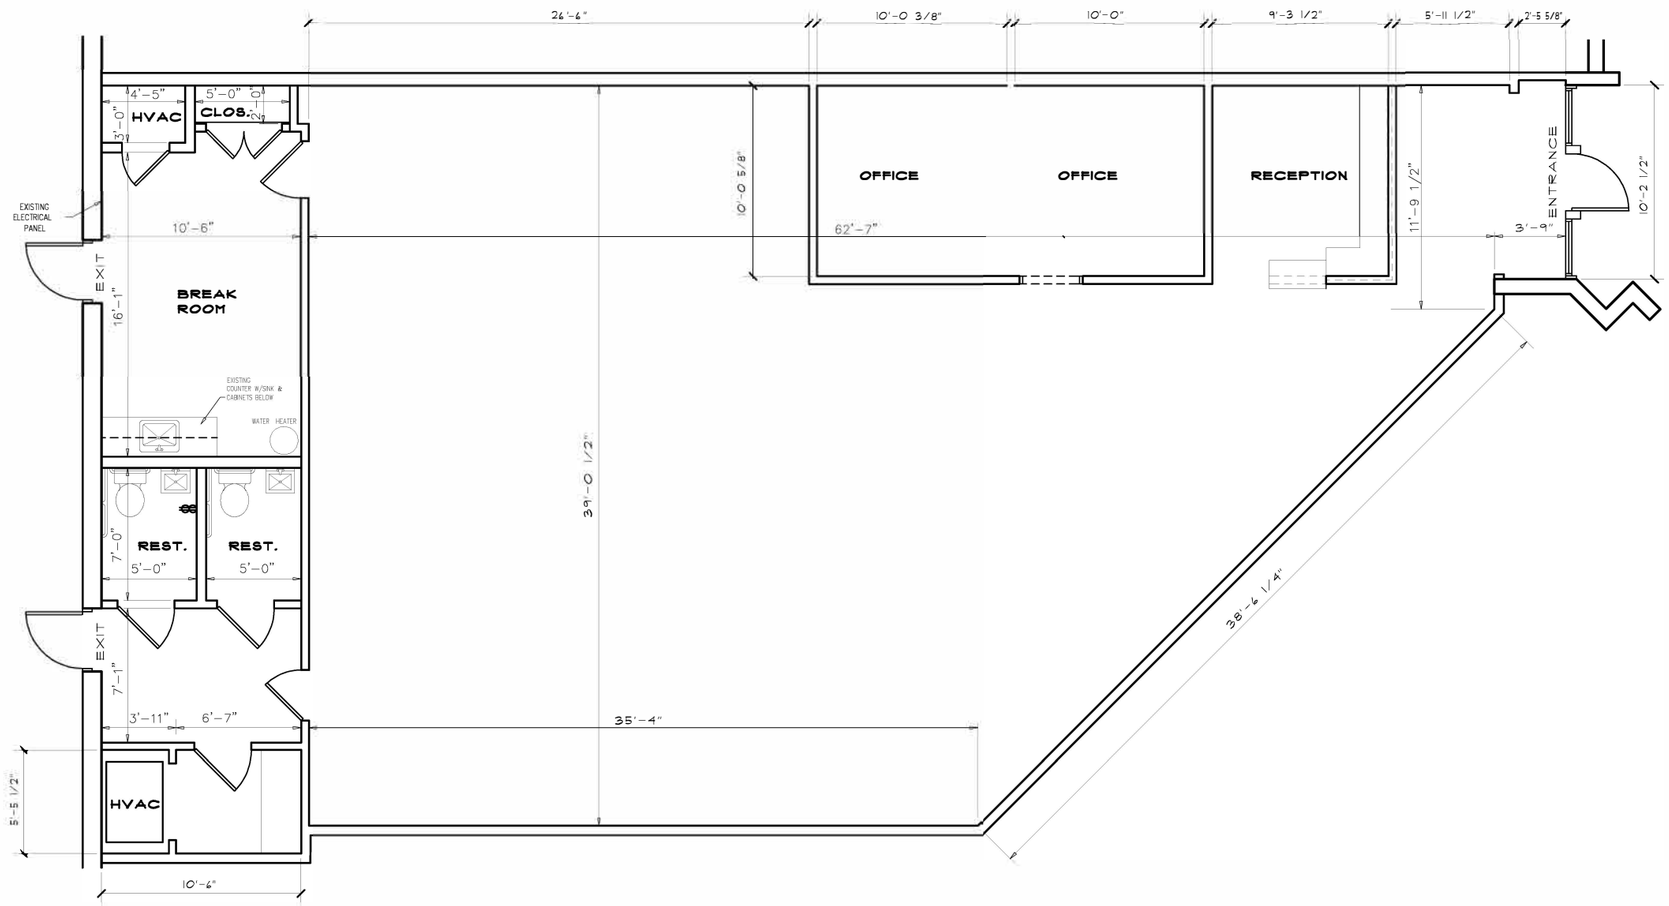


# AS-BUILT FLOOR PLAN

| CHICKASAW CROSSING<br>2867 POPLAR AVE. MEMPHIS, TN | | | LPI<br>MEMPHIS<br>5264 POPLAR AVENUE<br>MEMPHIS, TN 38119 |
|---|---|---|---|
| SCALE<br>1/8"=1'-0" | DATE<br>9/9/25 | VERSION | |