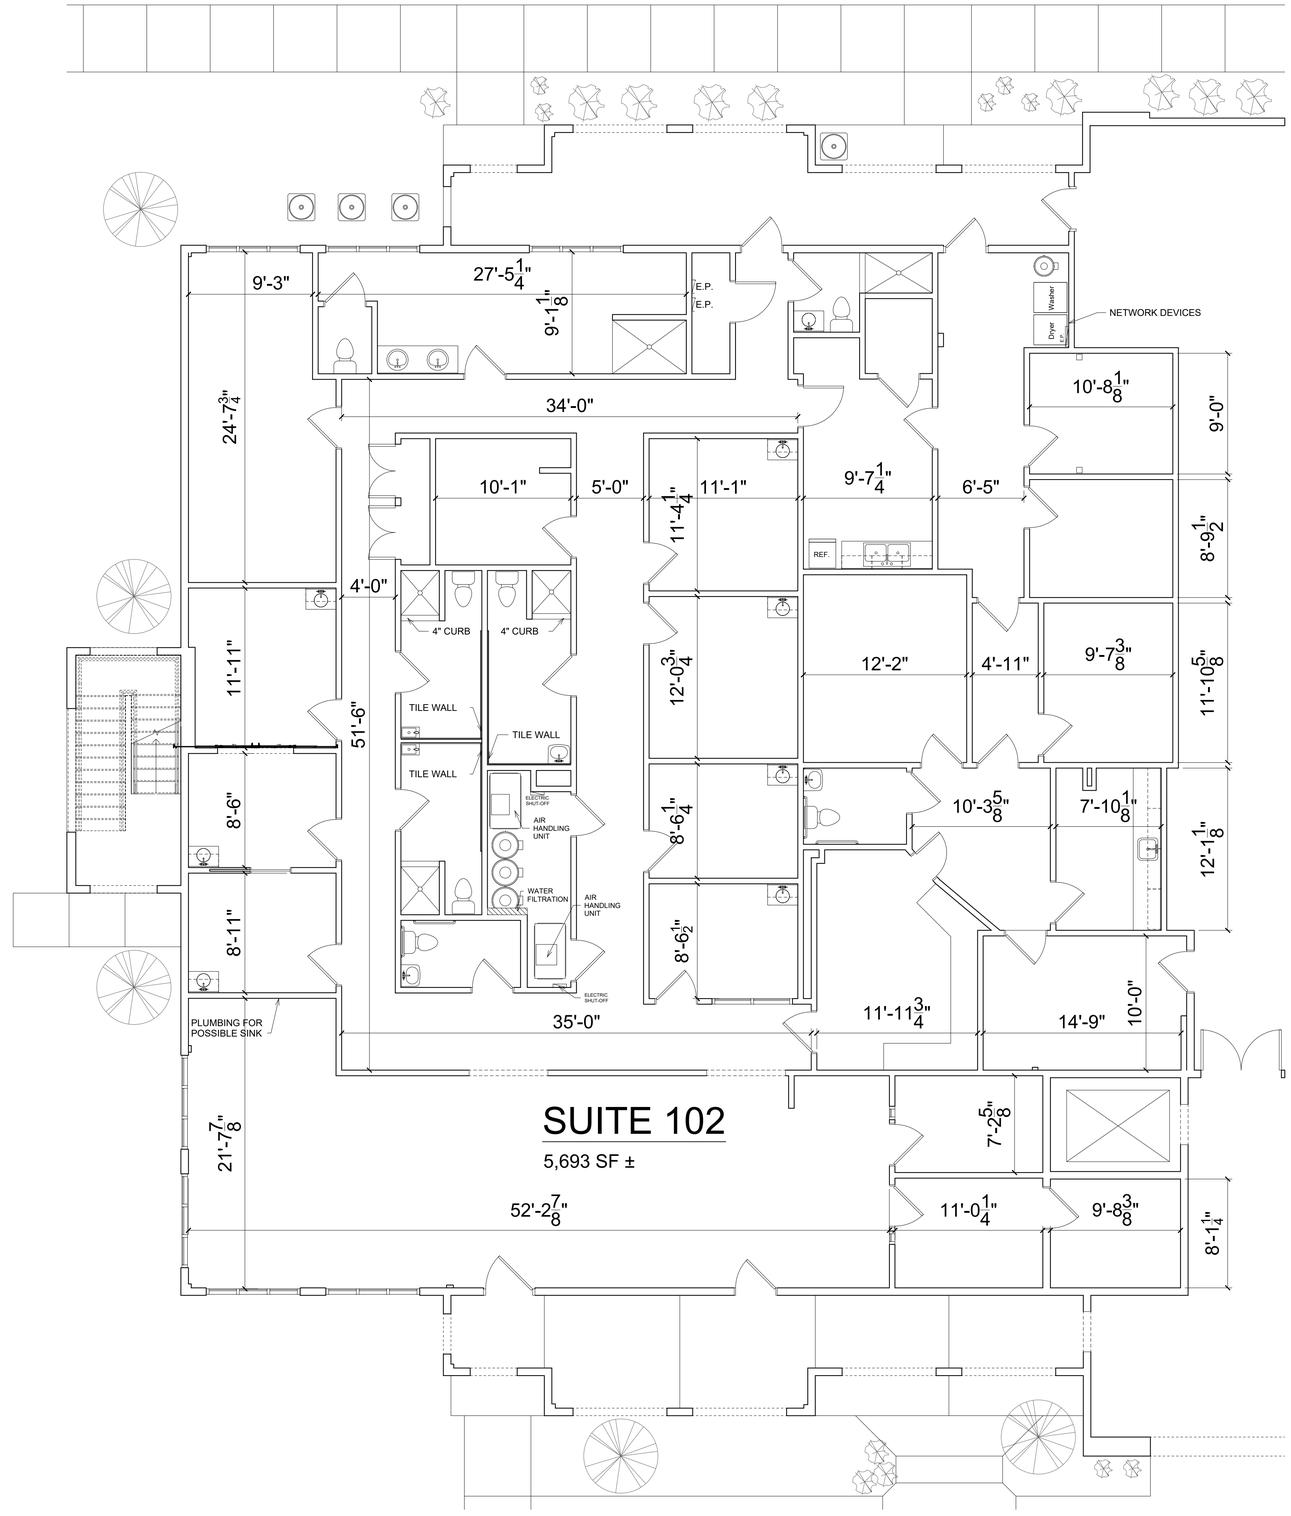

1 / A2.0 AS-BUILT FLOOR PLAN - SUITE 102

SCALE: 1/4" = 1'-0"

0 2 4 8

PINNACLE
LEASING & MANAGEMENT

KEY PLAN 1" = 50'

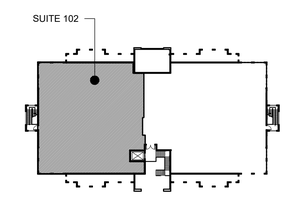

870 CRESTMARK DRIVE
1ST FLOOR

ALL Architecture, LLC
2052 CHRYSLER DRIVE NE, ATLANTA, GA 30345
TELEPHONE: (404) 316-2896
E-MAIL: INFO@ALLARCHLLC.COM

REVISIONS	
NO.	DATE

COPYRIGHT
THIS DRAWING AND ALL REPRODUCTIONS ARE COPYRIGHTED AND THE PROPERTY OF ALL ARCHITECTURE, LLC AND MAY NOT BE USED IN ANY WAY WITHOUT THEIR PERMISSION.

PROJECT TITLE:
870 CRESTMARK DRIVE
SUITES 102 AS-BUILTS
870 CRESTMARK DRIVE
SUITES 102
LITHIA SPRINGS, GEORGIA 30122

SEAL:

PRELIMINARY

DRAWN: JRM, JCA	CHECKED: JCA
APPROVED: JCA	ISSUE DATE: 04/20/25

CAD FILE NAME: 25025.dwg

SHEET TITLE: AS-BUILT FLOOR PLAN - SUITE 102

PROJECT NUMBER: 25025

SHEET NO: A2.0

NOT ISSUED FOR CONSTRUCTION

PLOT DATE: 4/20/2025 8:34:10 PM