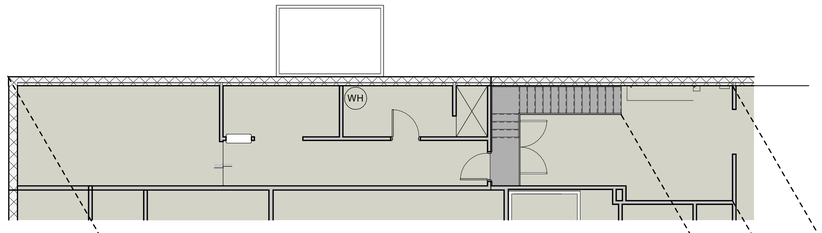

2 **Mezzanine**
1/8" = 1'-0"

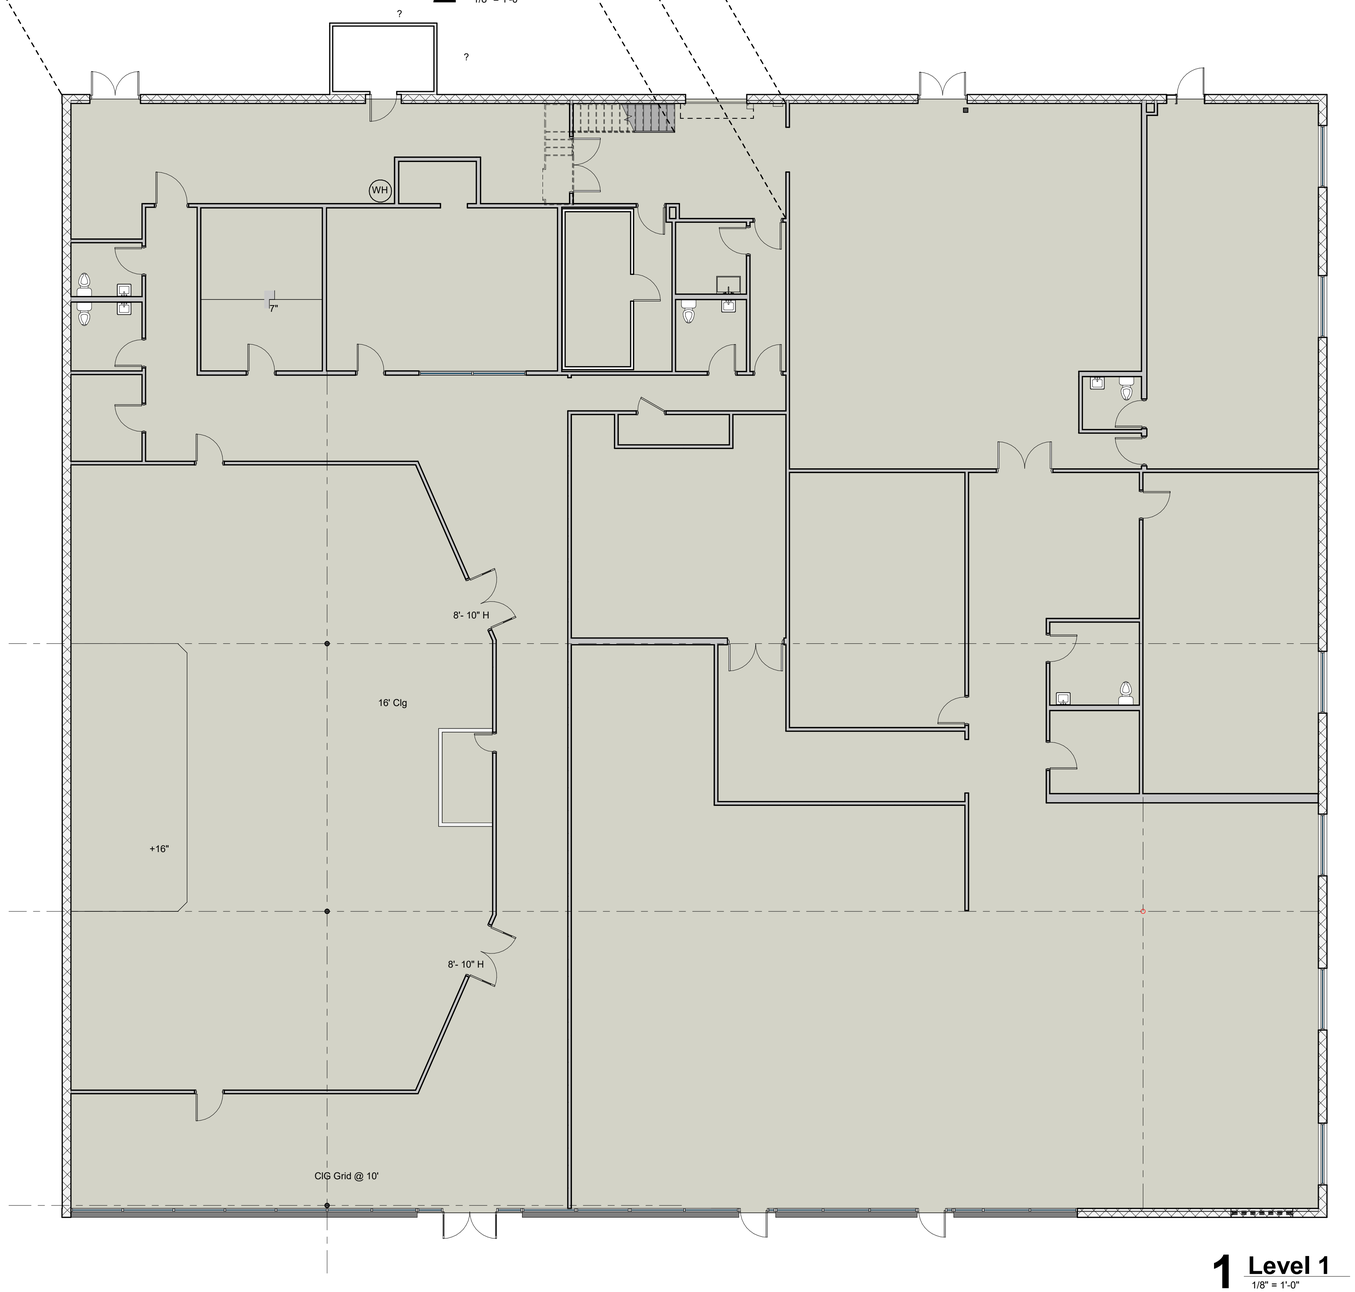

1 **Level 1**
1/8" = 1'-0"

REVISIONS

FISHER
Fisher Architects, PA
351 Merrimon Avenue
Asheville, NC 28801
(828) 253-8265
Copyright 2024 Fisher Architects, PA

STRATUS PROPERTY GROUP

Shoppes of Rome St.
As Built Plans
Stratus Prpperty Group
415 Rome Street, Carrollton, GA 30117

SHEET TITLE
Part A - Plan

SHEET
A1.1

DATE
02-03-2025

JOB NO.
24-0240