32 Avenue of the Americas

Rudín

19th Floor
As Built Plan

45,021 Sq. Ft.
Full Floor Available Immediately

Lispenard St

Avenue of the Americas

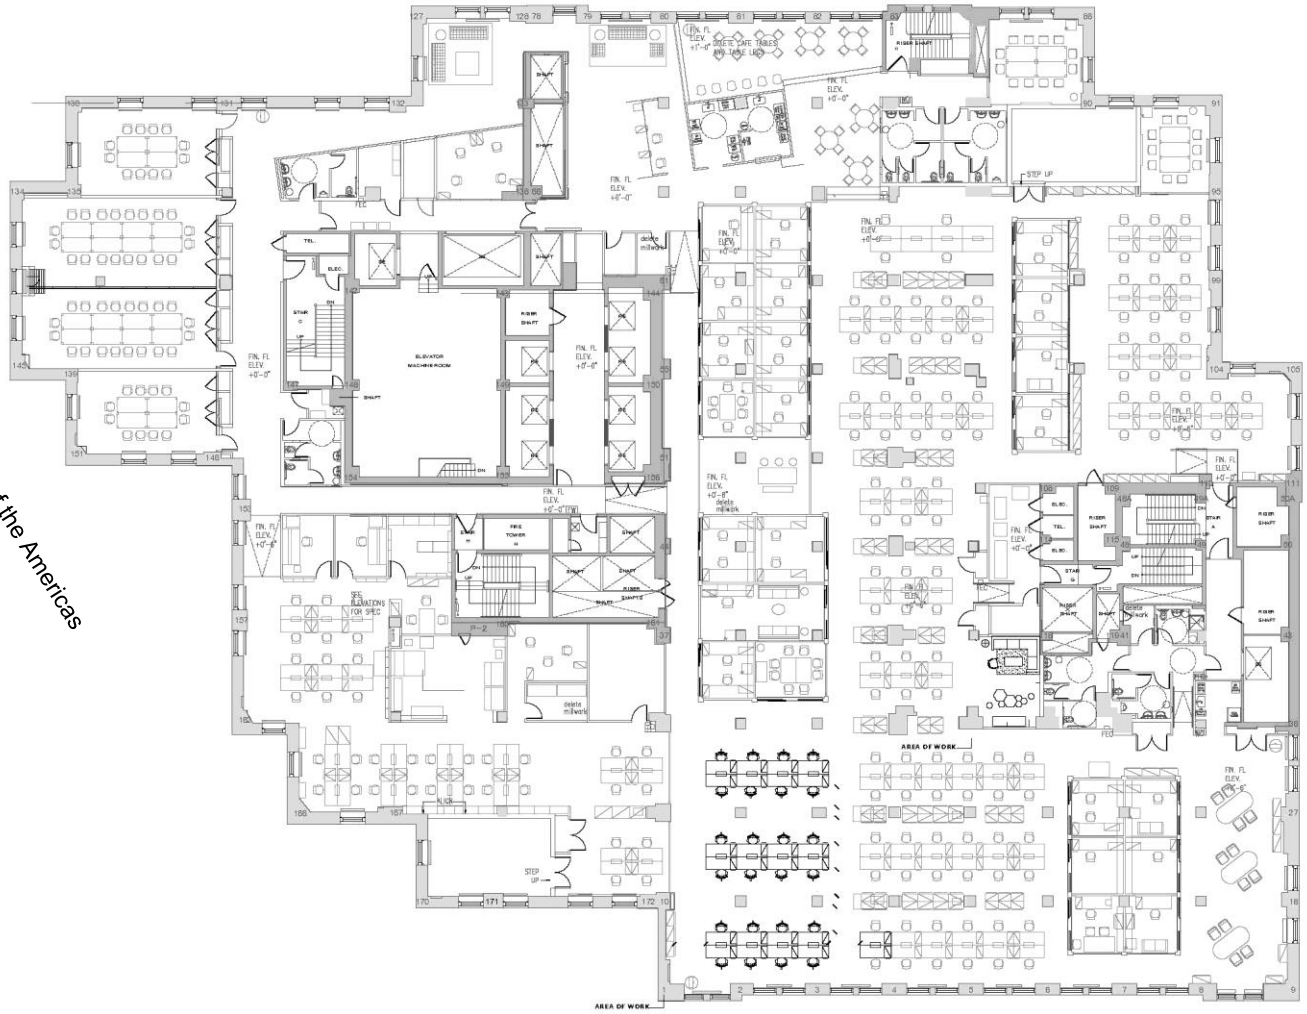

Church St

Walker St

Robert Steinman

212.407.2490
rsteinman@rudin.com

rudin.com

REBNY