Property Key

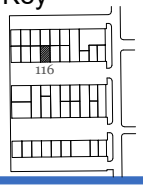

1,495 RSF +/- As Built Marketing Package

7330 Rampart St
Suite 116
Houston, TX 77081

Sheet A1
Of 1 Sheet(s)

Scale: Not to Scale
Sheet Size: 11" x 8.5"
Not For Construction

BAY SPACE

© 2025 HosScans, LLc.
All right reserved.
These drawings and any associated documents are protected under U.S. copyright law. No part of this work may be produced, distributed, or used in any form, by any method, for any purpose, without the prior written consent of HosScans, LLC. Unauthorized use is subject to legal action.

Usable Square Foot Analysis

OFFICE AREA:	240	16%
WAREHOUSE AREA:	1,237	84%
OVERHANG AREA:	18	
TOTAL AREA:	1,495	

Building Information

Deck Height:	14'1"
Clear Height:	11'10"
Ceiling Height:	7'10"
Sprinklered:	No
Mechanical Area:	N/A

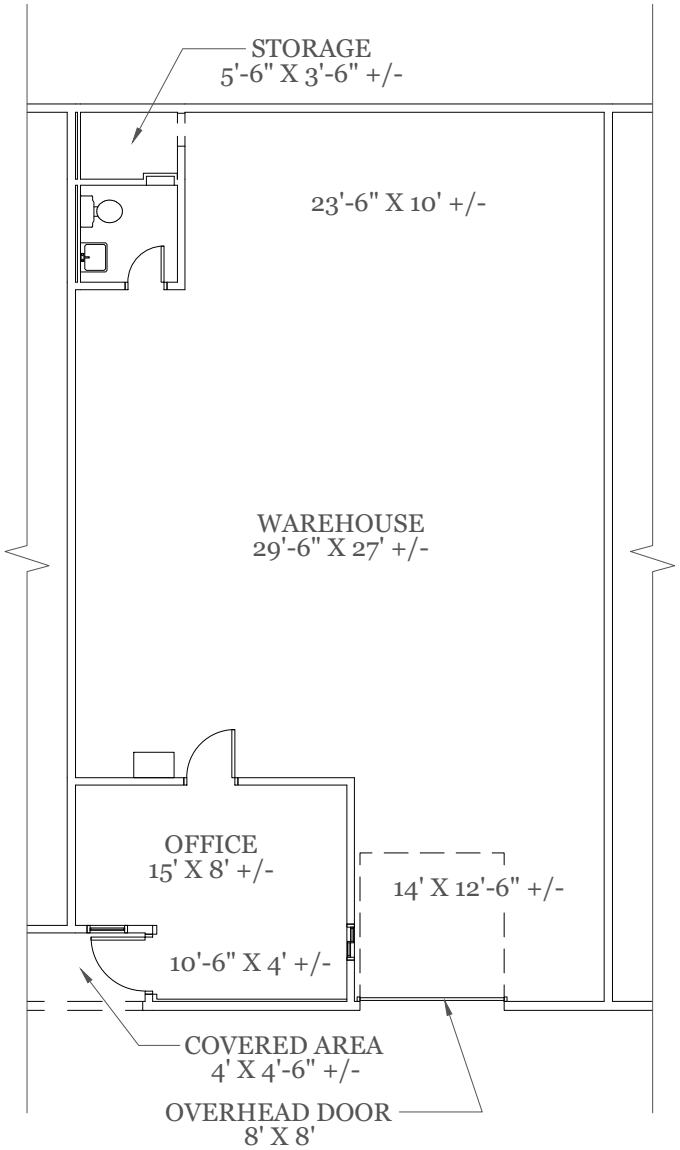

As Built Floor Plan for Marketing