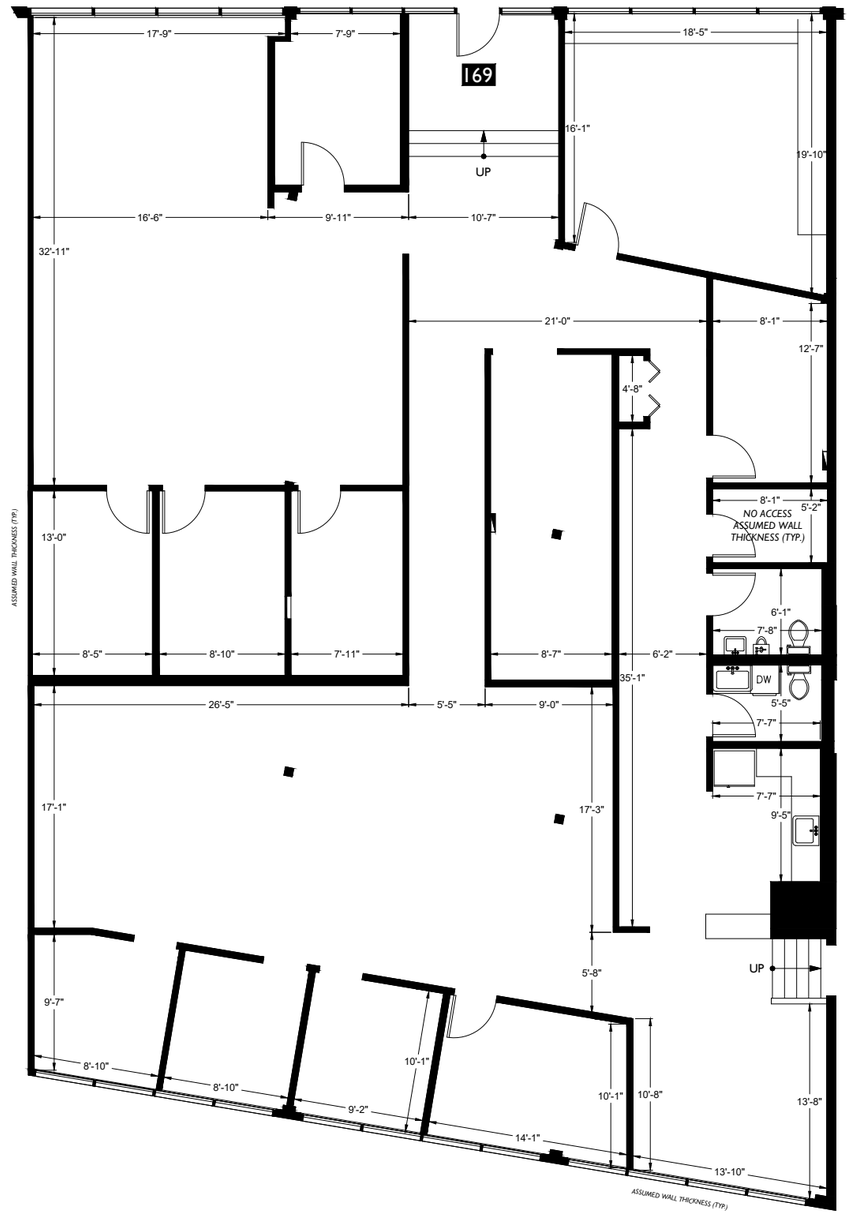

0 10 20 30

Scale: 3/32" = 1'-0"

Western Ave W

2-D AS-BUILT FLOOR PLANS

2DFLOORPLANS.COM

371 NW Gilman Blvd.
Suite 140
Issaquah, WA 98027
425-677-7511

This drawing is an instrument of service and is the sole property of the client listed. Any alteration of this drawing without removal of references to 2-D As-Built Floor Plans, Inc. is prohibited.

Drawing scale and dimensions are provided for reference only. Refer to CAD files for exact measurements.

©2010 2-D As-Built Floor Plans, Inc. All Rights Reserved.

Project: C23-424

Date Project	Action
05/16/23 C23-424	Initial Site Measure

Client:
Northwest Work Lofts
3131 Western Ave, Suite 419
Seattle, WA 98119

Site:
Offices
169 Western Ave W
Seattle, WA 98119

Floor Plan

2

Floor