☆ shut off valve

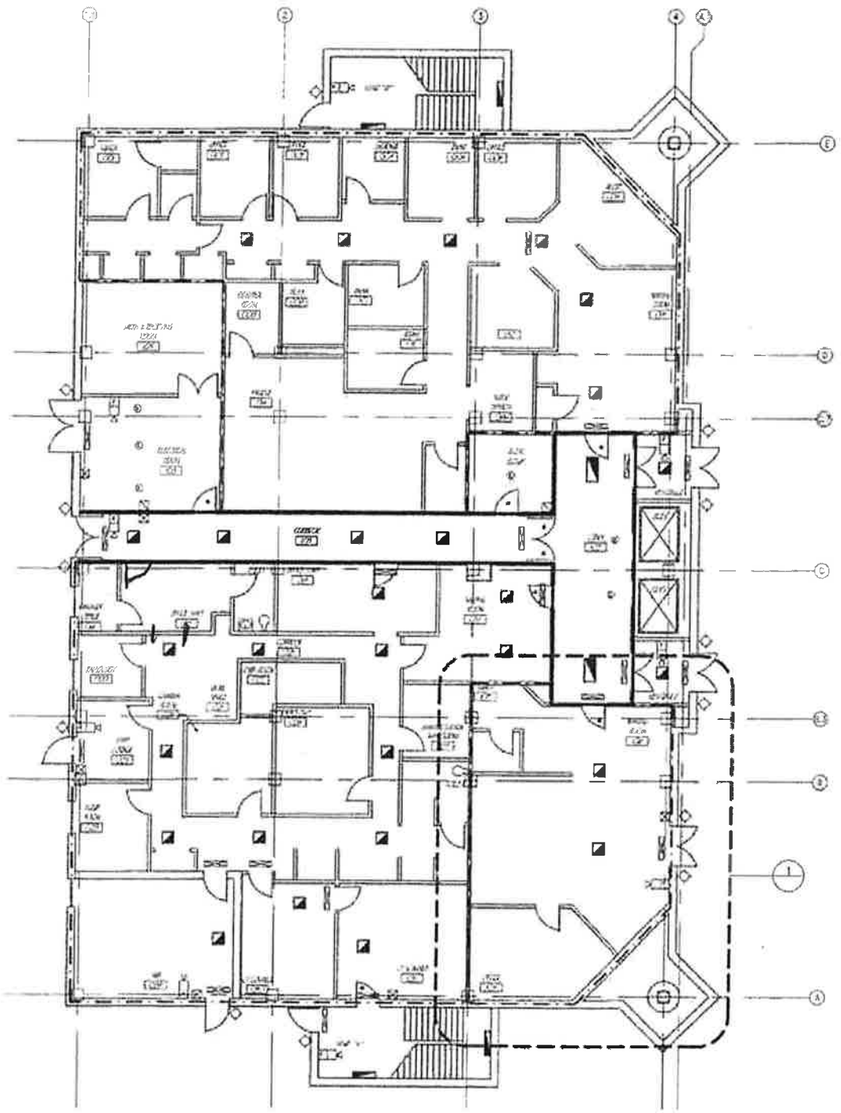

FIRST FLOOR PLAN
SCALE: 1/8"=1'-0"

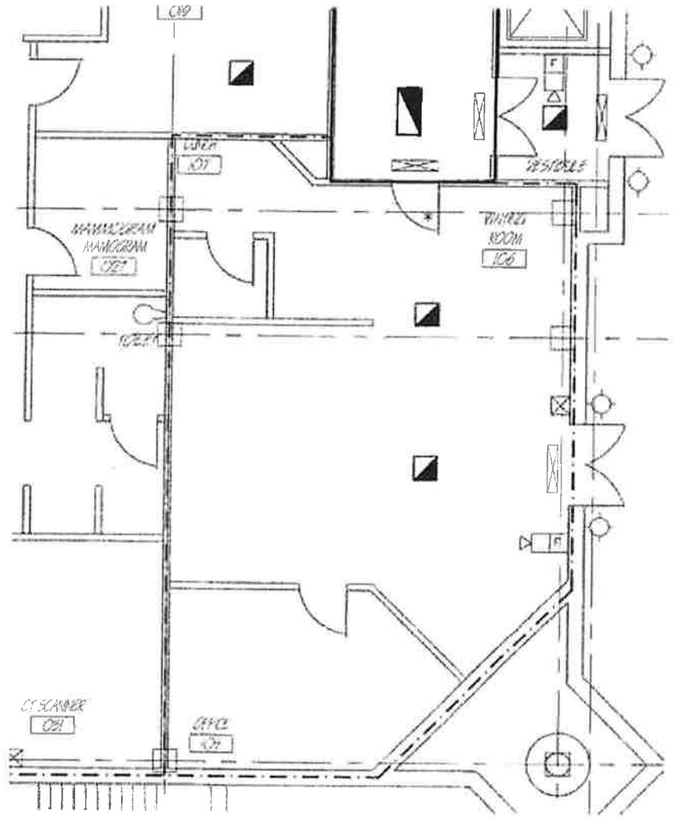

ENLARGED FLOOR PLAN
SCALE: 1/4"=1'-0"

GREATER PITTSBURGH TRAVEL

LEGEND

EXTERIOR EMERGENCY LIGHTING

INDICATES LIGHTING FIXTURES ON EMERGENCY CIRCUIT

SMOKE DETECTORS

FIRE PULL STATIONS

FIRE HORN STROBE UNITS

ILLUMINATED EXIT SIGN

INDICATES 1 HR RATED WALLS FROM SLAB TO UNDERSIDE OF DECK, w/ FIRE-STOPPING - UL-465

(2 HR. RATED SHAFT WALLS AROUND ELEVATORS & DUCT SHAFTS UL-438

INDICATES "C" LABEL SOLID CORE DOORS IN RATED WALLS

(NOTE: ALL DOORS IN STAIR TOWERS: "B" LABEL METAL DOORS)

F.E./B — 10 LB. CAP. MODEL SENTRIC 10 UD-UL RATING 10BC. USE MB-884 TYPE FIRE EXTINUISHER WALL BRACKETS

F.E./CAB — 10 LB. CAP. MODEL COSMIC 10E-UL RATING 4A-60 BC. USE CABINET "ACADEMY" SERIES IN RED'D. SIZE FOR SPECIFIED FIRE EXTINGUISHER

JOSEPH J. BALOBECK AND ASSOCIATES
200 dinsmore avenue
pittsburgh, pennsylvania
412-928-0210

KENNEDY MEDICAL ARTS BUILDING

JOSEPH J. BALOBECK, JR.
REGISTERED ARCHITECT
200 DINSMORE AVE
PITTSBURGH, PA 15205

DATE SEPT. 2005

A-1

job no.