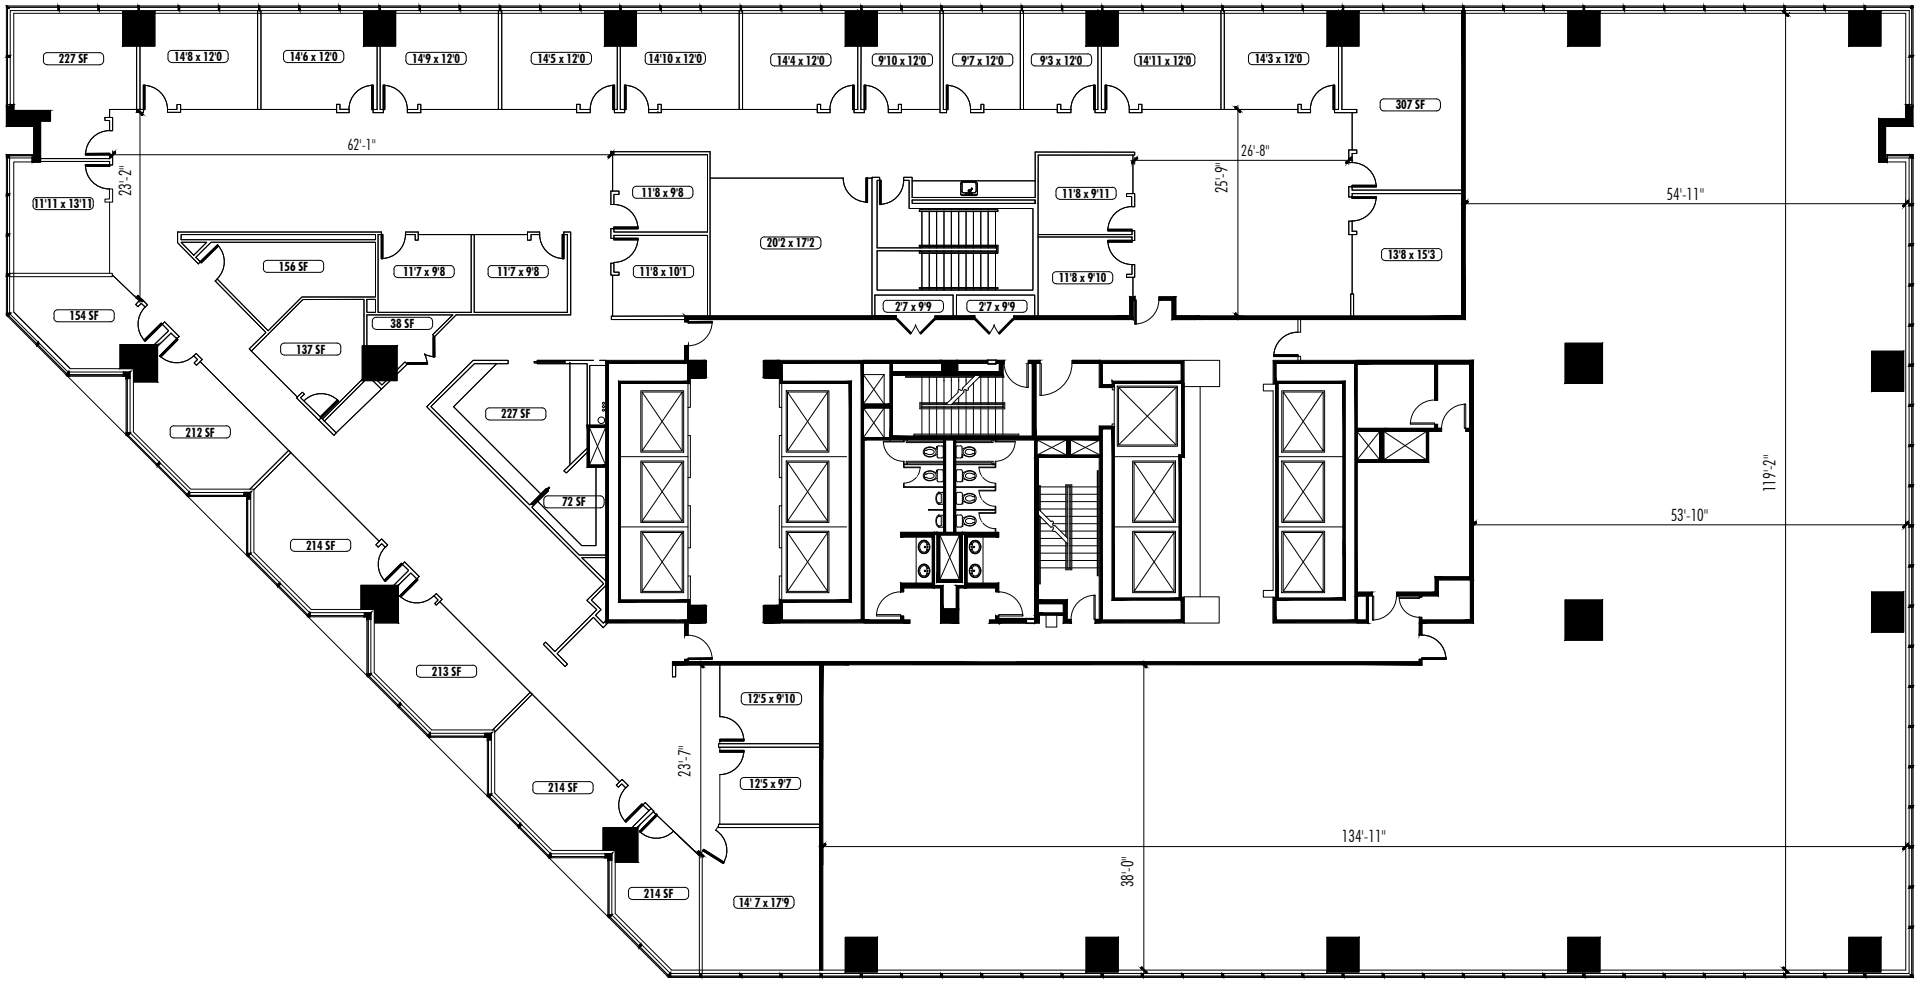

North

Salesforce Tower

JLL

BANYAN STREET CAPITAL

NELSON

Salesforce Tower • Suite 1400 • 26,152 RSF

As-Built Diagram

AB14

06.15.22