

ALLEN CORPORATE CENTER


740-800 N. Watters Road, Allen, TX 75013

For Lease



OFFERING SUMMARY

Lease Rate:	\$22 SF/yr (NNN)
Available SF:	1,965 - 5,279 SF
Year Built:	2015
Submarket:	Allen/McKinney

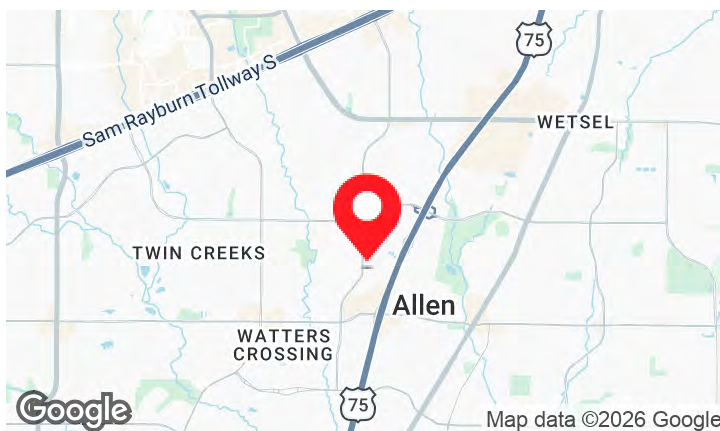

PROPERTY OVERVIEW

Door-side parking, with great drive up appeal. Tenants have 24/7 access and HVAC control. Local and responsive ownership.

Easy access to Central Expressway and Highway 121 (Sam Rayburn Tollway) via McDermott Drive, Watters Road and Exchange Avenue. Close to wide variety of restaurants and hotels.


PROPERTY HIGHLIGHTS

- 4.9/1,000 Parking Ratio
- Floor to ceiling glass
- Private entry and restrooms
- OPEX for 740 N Watters estimated at \$8.76/SF/Year
- OPEX for 760 N Watters estimated at \$8.63/SF/Year
- OPEX for 780 N Watters estimated at \$9.47/SF/Year
- OPEX for 800 N Watters estimated at \$9.24/SF/Year

ALLEN CORPORATE CENTER

740-800 N. Watters Road, Allen, TX 75013

For Lease

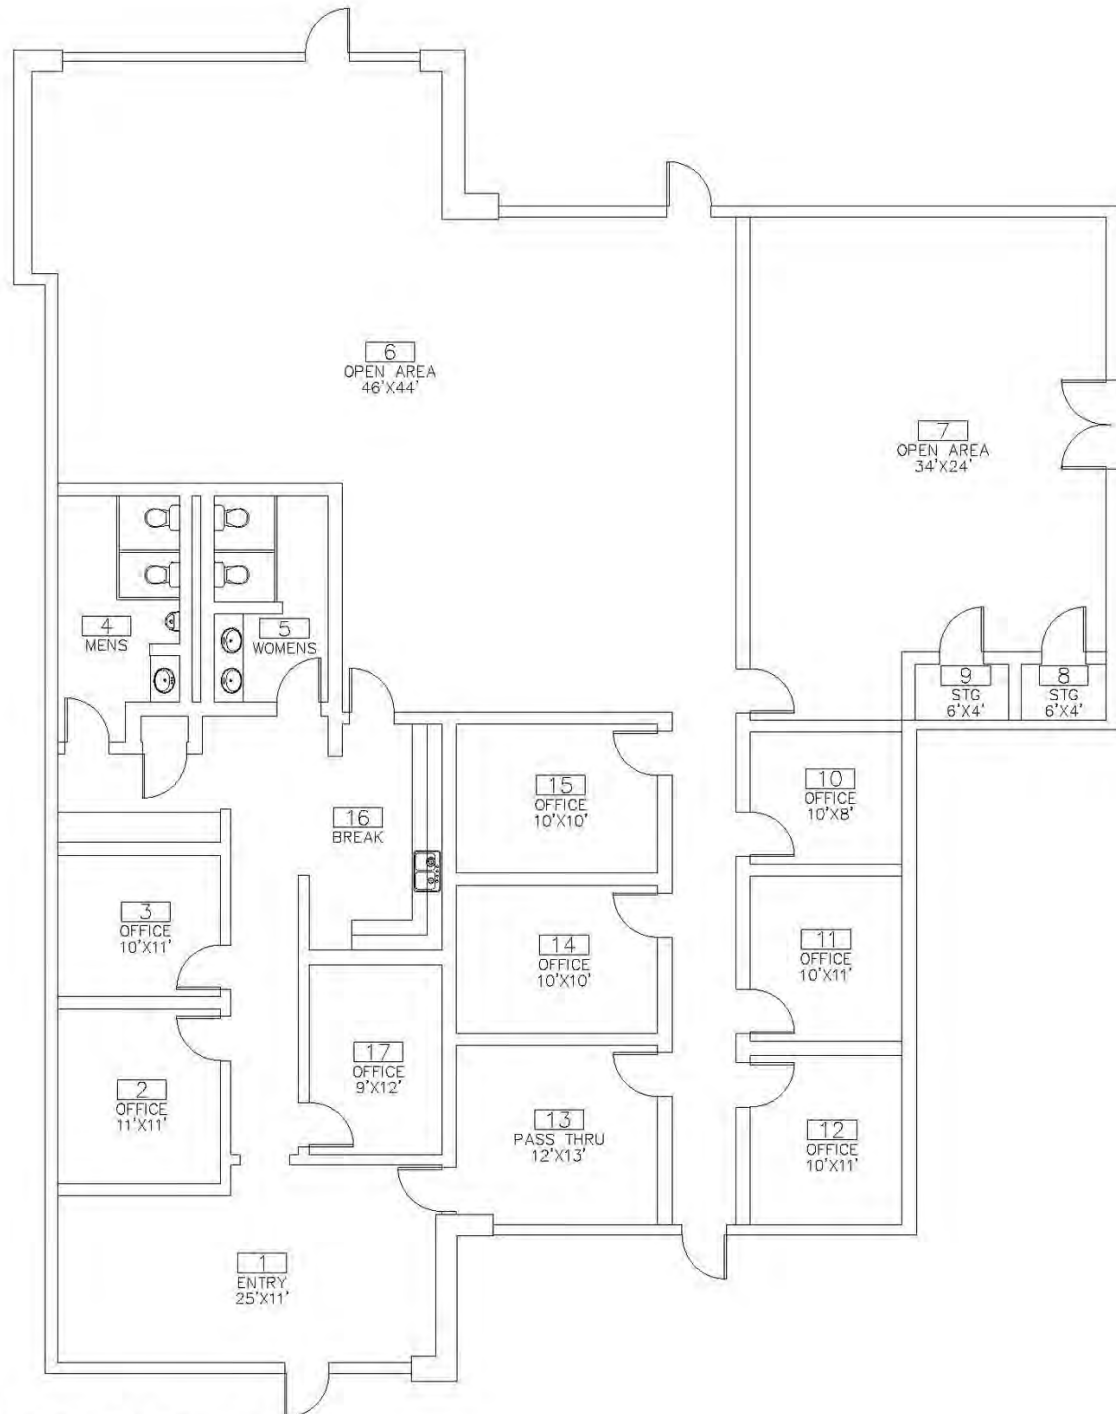

1 FLOOR PLAN - SUITE 150
SCALE: 3/32" = 1'-0"

FOR REFERENCE ONLY

1/10/2022

800 NORTH WATTERS RD.
ALLEN, TX
AS-BUILT PLAN




800 N Watters Road - CC1, Suite 150 - 5,279 SF

ALLEN CORPORATE CENTER

740-800 N. Watters Road, Allen, TX 75013

For Lease

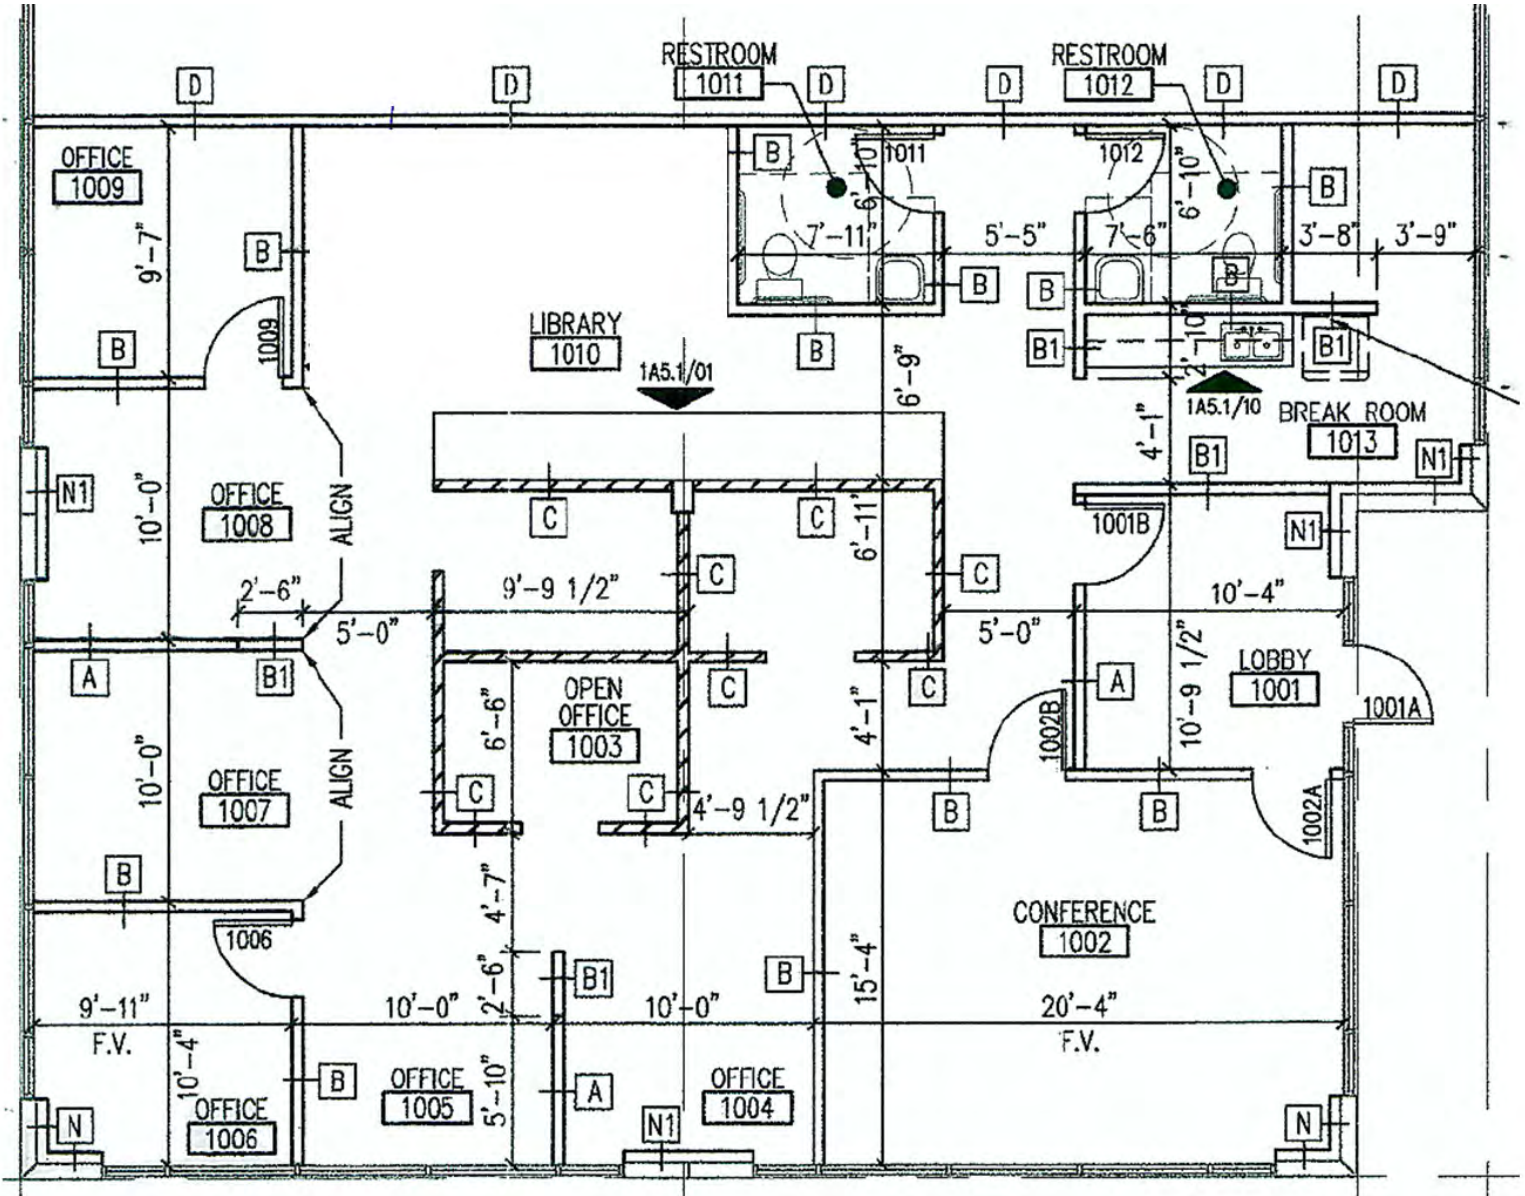


780 N Watters Road - CC2, Suite 100 - 2,112 SF

ALLEN CORPORATE CENTER

740-800 N. Watters Road, Allen, TX 75013

For Lease

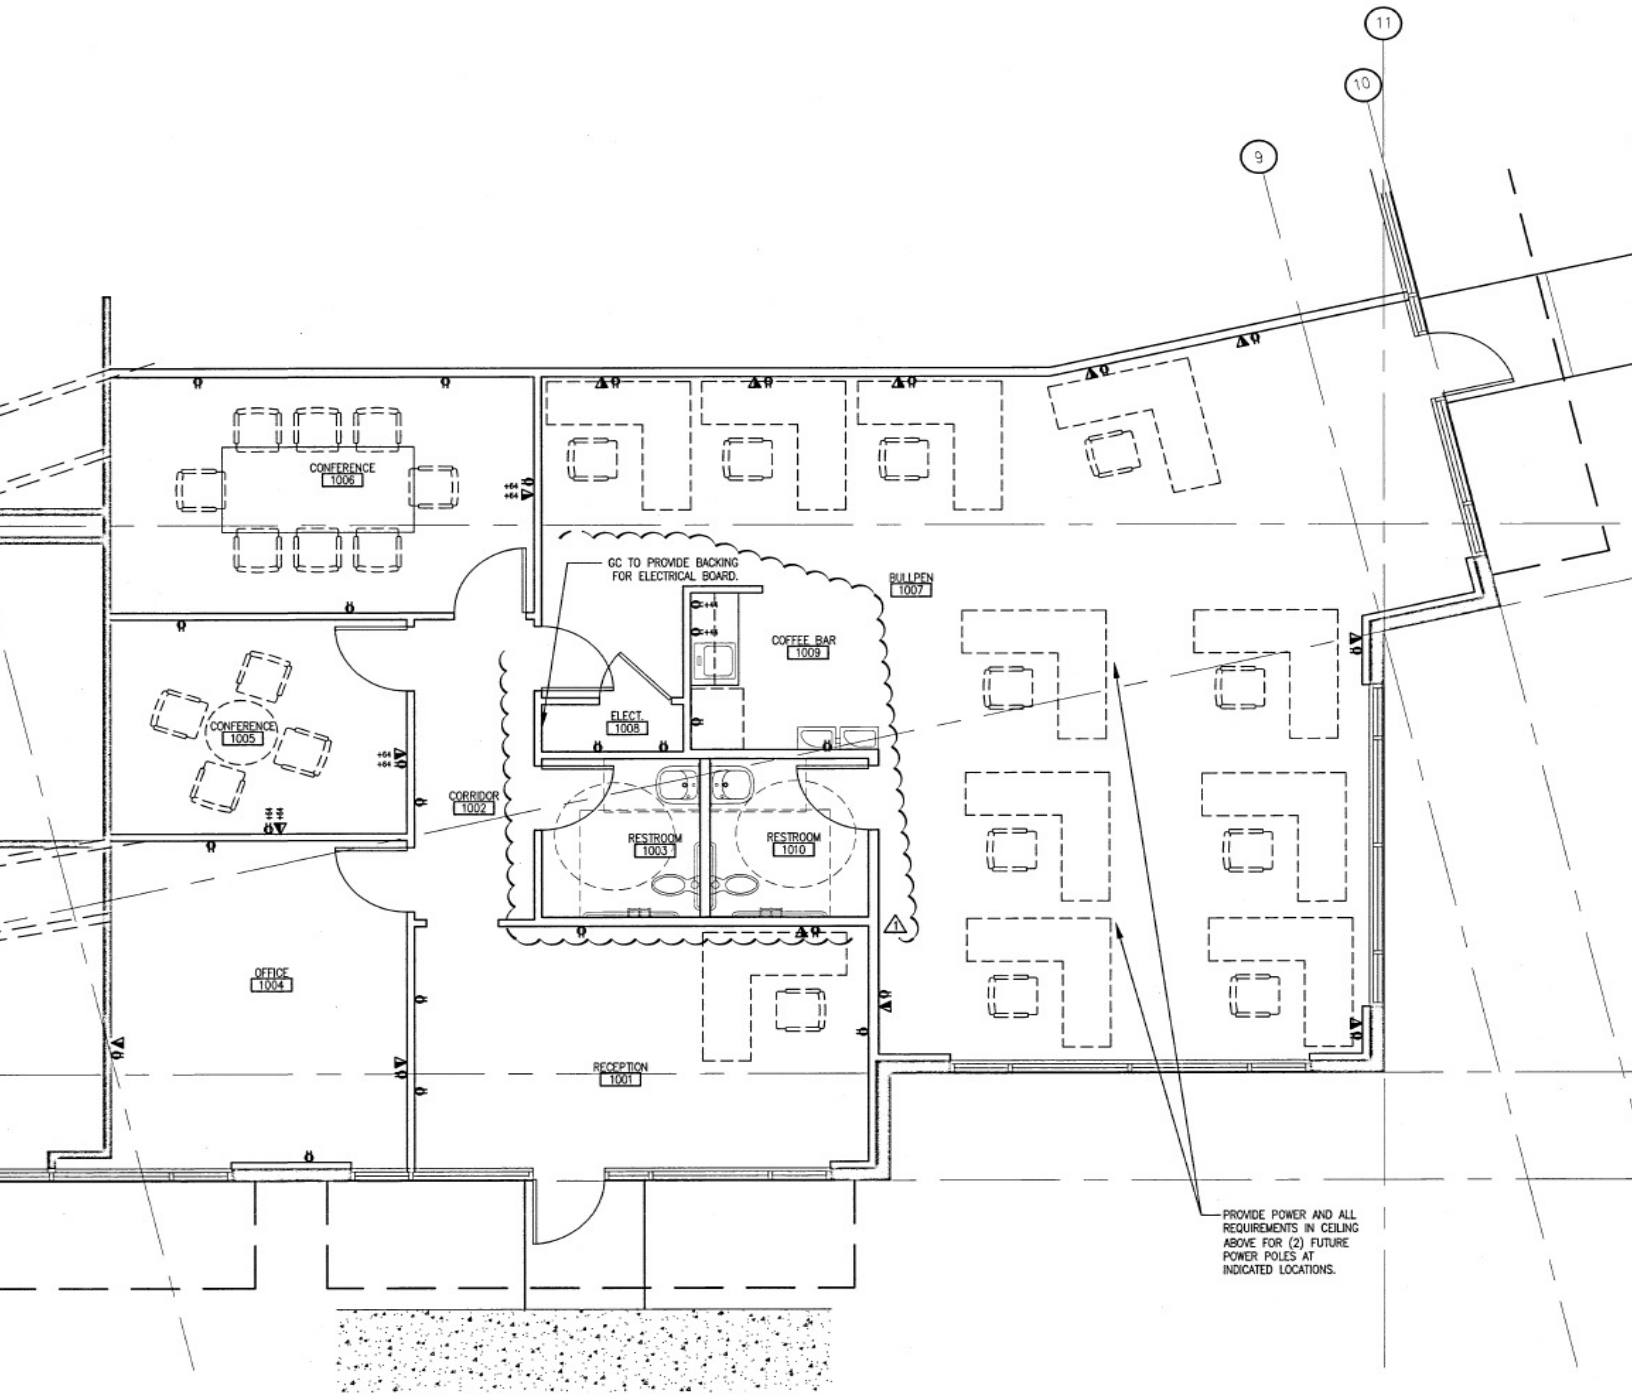


760 N Watters Road - CC3, Suite 150 - 1,965 SF

ALLEN CORPORATE CENTER

740-800 N. Watters Road, Allen, TX 75013



For Lease

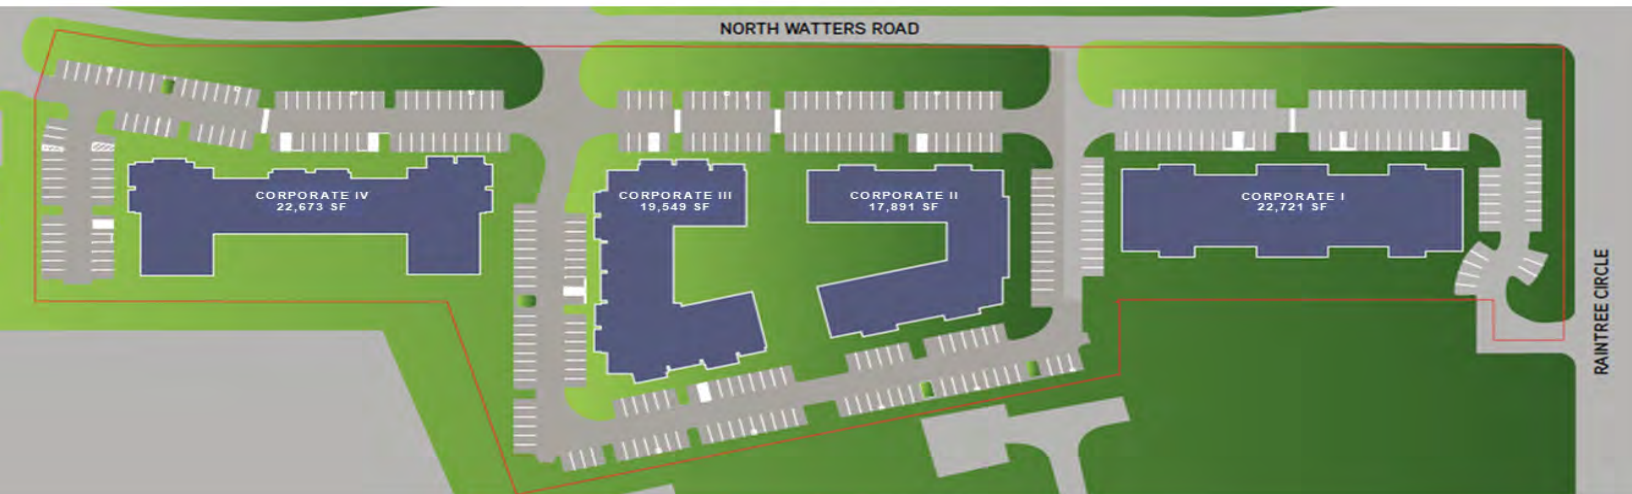



16479 Dallas Parkway
Suite 140
Addison, TX 75001

HudsonPeters.com



MICHELLE HUDSON, SIOR, CCIM

214.389.3663

Hudson@HudsonPeters.com



TOM HUDSON, SIOR, CCIM

214.389.3667

Tom@HudsonPeters.com

The information contained herein was obtained from sources believed reliable; however, Hudson Peters Commercial LLC makes no guarantees, warranties or representation as to the completeness or accuracy thereof. The presentation of properties and pricing is submitted subject to errors, omissions, change of price or condition prior to sale or lease or withdrawal without notice. Unless expressly stated otherwise, nothing contained in this message should be construed as a digital or electronic signature, nor is it intended to reflect an intention to make an agreement by electronic means.



Information About Brokerage Services

Texas law requires all real estate license holders to give the following information about brokerage services to prospective buyers, tenants, sellers and landlords.

2-10-2025



TYPES OF REAL ESTATE LICENSE HOLDERS:

- **A BROKER** is responsible for all brokerage activities, including acts performed by sales agents sponsored by the broker.
- **A SALES AGENT** must be sponsored by a broker and works with clients on behalf of the broker.

A BROKER'S MINIMUM DUTIES REQUIRED BY LAW (A client is the person or party that the broker represents):

- Put the interests of the client above all others, including the broker's own interests;
- Inform the client of any material information about the property or transaction received by the broker;
- Answer the client's questions and present any offer to or counter-offer from the client; and
- Treat all parties to a real estate transaction honestly and fairly.

A LICENSE HOLDER CAN REPRESENT A PARTY IN A REAL ESTATE TRANSACTION:

AS AGENT FOR OWNER (SELLER/LANDLORD): The broker becomes the property owner's agent through an agreement with the owner, usually in a written listing to sell or property management agreement. An owner's agent must perform the broker's minimum duties above and must inform the owner of any material information about the property or transaction known by the agent, including information disclosed to the agent or subagent by the buyer or buyer's agent. **An owner's agent fees are not set by law and are fully negotiable.**

AS AGENT FOR BUYER/TENANT: The broker becomes the buyer/tenant's agent by agreeing to represent the buyer, usually through a written representation agreement. A buyer's agent must perform the broker's minimum duties above and must inform the buyer of any material information about the property or transaction known by the agent, including information disclosed to the agent by the seller or seller's agent. **A buyer/tenant's agent fees are not set by law and are fully negotiable.**

AS AGENT FOR BOTH - INTERMEDIARY: To act as an intermediary between the parties the broker must first obtain the written agreement of *each party* to the transaction. The written agreement must state who will pay the broker and, in conspicuous bold or underlined print, set forth the broker's obligations as an intermediary. A broker who acts as an intermediary:

- Must treat all parties to the transaction impartially and fairly;
- May, with the parties' written consent, appoint a different license holder associated with the broker to each party (owner and buyer) to communicate with, provide opinions and advice to, and carry out the instructions of each party to the transaction.
- Must not, unless specifically authorized in writing to do so by the party, disclose:
 - that the owner will accept a price less than the written asking price;
 - that the buyer/tenant will pay a price greater than the price submitted in a written offer; and
 - any confidential information or any other information that a party specifically instructs the broker in writing not to disclose, unless required to do so by law.

AS SUBAGENT: A license holder acts as a subagent when aiding a buyer in a transaction without an agreement to represent the buyer. A subagent can assist the buyer but does not represent the buyer and must place the interests of the owner first.

TO AVOID DISPUTES, ALL AGREEMENTS BETWEEN YOU AND A BROKER SHOULD BE IN WRITING AND CLEARLY ESTABLISH:

- The broker's duties and responsibilities to you, and your obligations under the representation agreement.
- Who will pay the broker for services provided to you, when payment will be made and how the payment will be calculated.

LICENSE HOLDER CONTACT INFORMATION: This notice is being provided for information purposes. It does not create an obligation for you to use the broker's services. Please acknowledge receipt of this notice below and retain a copy for your records.

Hudson Peters Commercial, LLC	582122	hudson@hudsonpeters.com	(972)980-1188
Licensed Broker /Broker Firm Name or Primary Assumed Business Name	License No.	Email	Phone
Lynn Michelle Hudson	433516	hudson@hudsonpeters.com	(972)980-1188
Designated Broker of Firm	License No.	Email	Phone
Licensed Supervisor of Sales Agent/ Associate	License No.	Email	Phone
Sales Agent/Associate's Name	License No.	Email	Phone

Buyer/Tenant/Seller/Landlord Initials

Date