GID

211 Perimeter Center PKWY NE, Suite 900,
Atlanta GA, 30346

BUILDING INFORMATION

Total Building:	56,078 SF
Suite Area:	13,492 SF
Warehouse Area:	9,835 SF
Office Area:	3,657 SF
Typ. Column Spacing:	32' x 40'
Sprinklered:	Yes

Symbol Legend:

- (D) Dock Doors
- (L) Dock Doors w/ Levelers
- (E) Electrical Panels
- (△) Drive In Doors

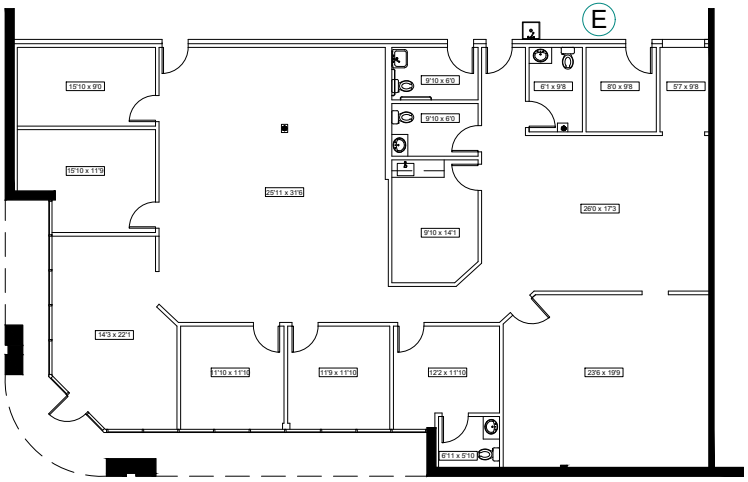

OFFICE PLAN

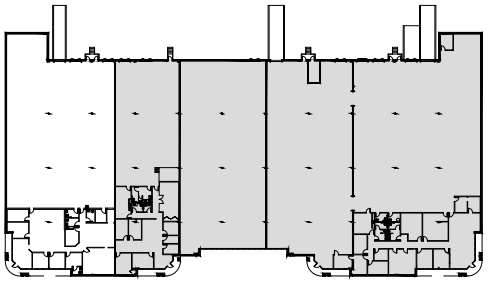

KEY PLAN

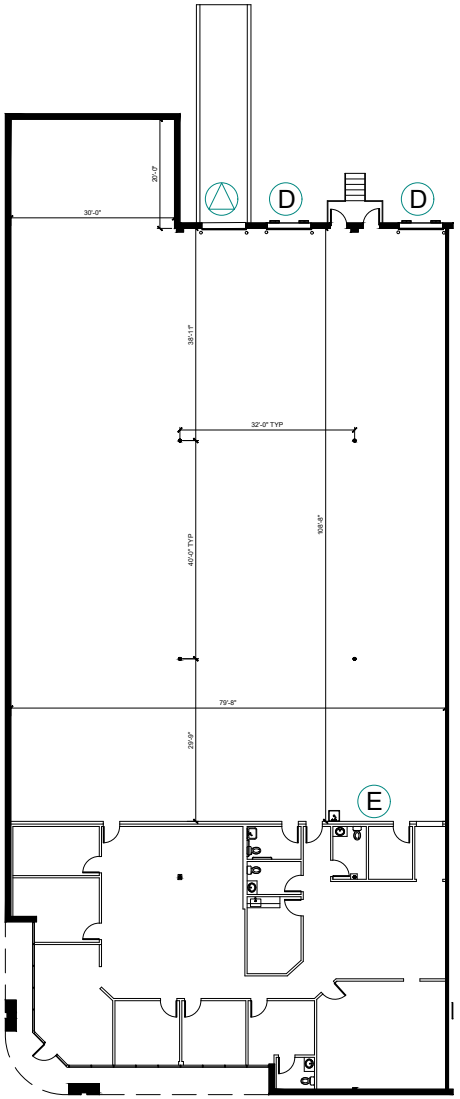

SUITE PLAN

1831 West Oak

Suite A

Marietta, GA 30062

Note: This conceptual plan is for marketing purposes only and has been prepared based on preliminary available site information deemed reliable. All dimension area calculations are subject to verification by a professional engineer for compliance with all federal, state and local regulations.

SMART interior group

As Built | 10.22.25