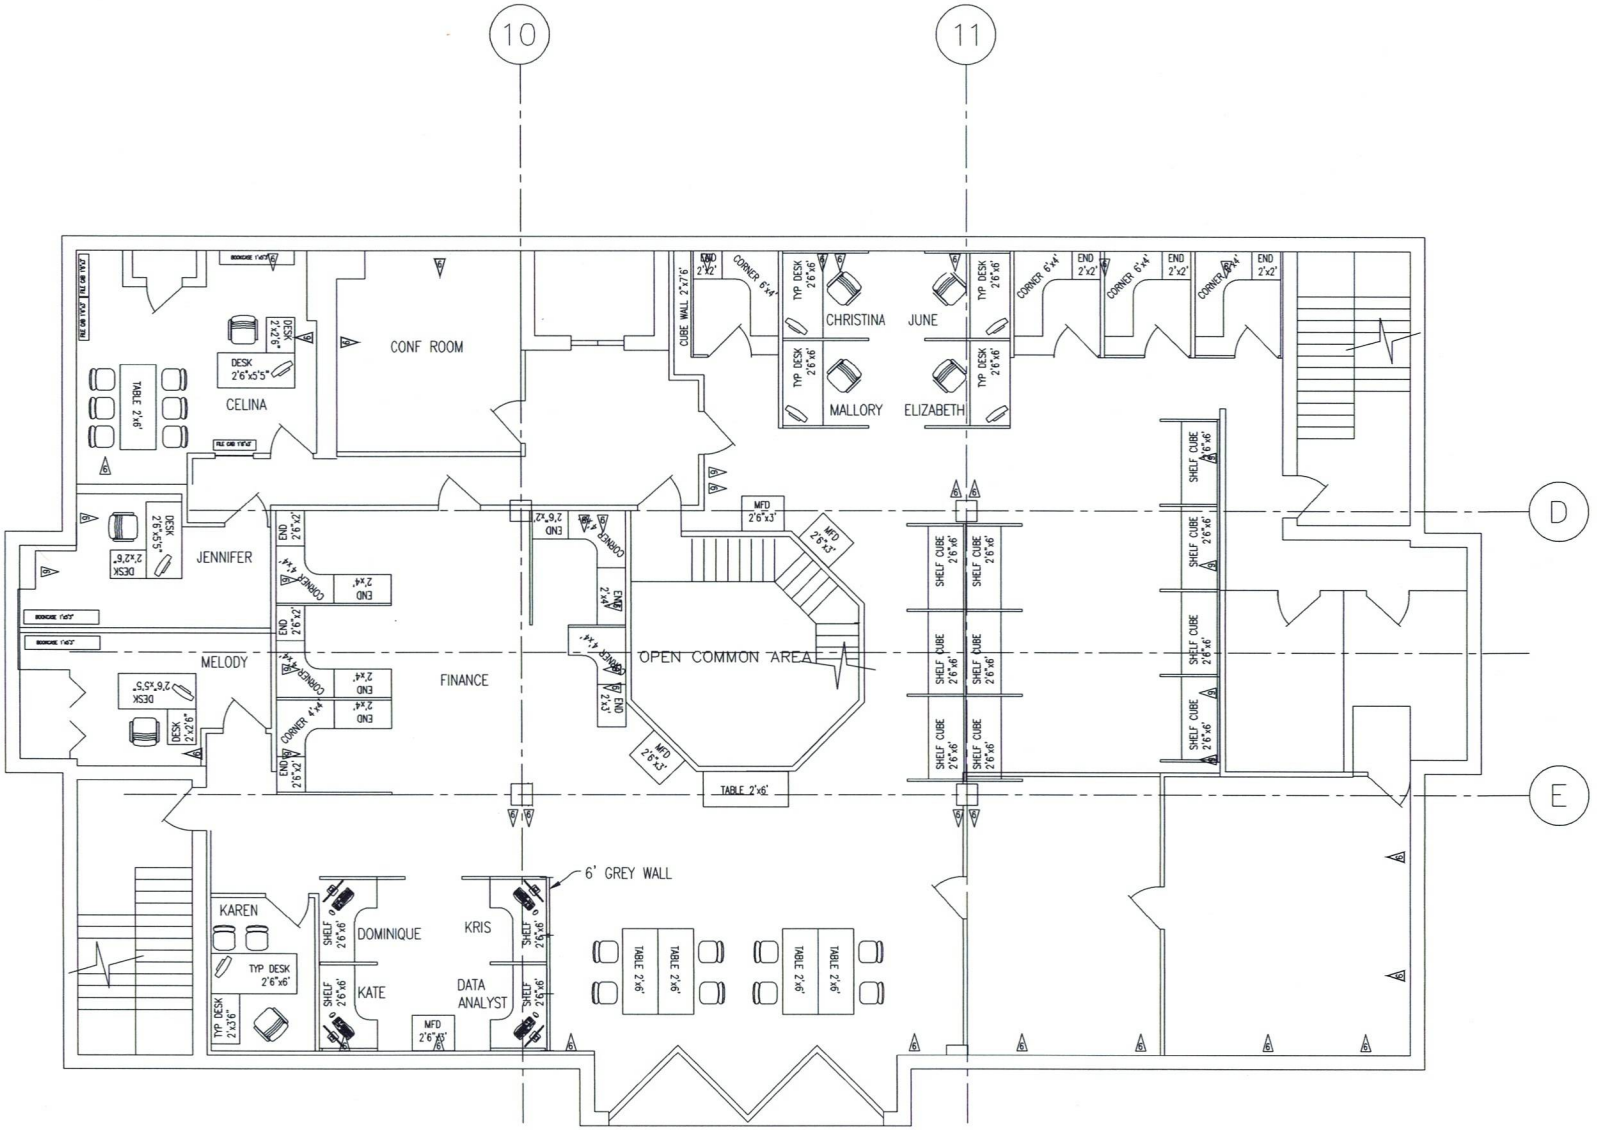

AS-BUILT PLAN
2ND FLOOR

SC: $\frac{1}{4}$"=1'-0"

EXISTING (CAT 4 OR 5) DATA SOCKET TO BE REUSED WITH CAT 6 CABLE / SOCKETS

NEW CAT 6 CABLE / SOCKETS